9:30

'ELL COUNTY HEALTH DEPARTMENT

STATESVILLE 70 -5305 MOORESVILLE 704-664-5281

IMPROVEMENT PERMIT / AUTHORIZATION TO CONSTRUCT / OPERATION PERMIT / EXISTING SYSTEM INSPECTION

PERMIT# 151238 PIN# 4638594825 DATE 9/29/30

OWNER OR APPLICANT Chad Young PHONE: Business 336.240.4148 Home 336.853.7878

ADDRESS 2740 michael Rd. Lexington, NC 27295

LOCATION Peach Rd. N. TL Stumpy Creek, on Left, 311 Stumpy Creek Rd.

SUBDIVISION CL&T BLOCK / SECTION 14 LOT 119 LOT AREA 0.83 acres SITE CLASS. P.S. DESIGN FLOW 450 gpd T.A.R. 0.3

Septic Tank: existing 1000 Gallons: STB existing Date existing
Pump Tank: 1000 Gallons: PT 27 Date 12-8-08
Pump Make: GOULDS Model WE05IZH Serial No. 1/2HP
Nitrification Field: No Fields 1 Square Feet 1600 Linear Feet 268
No Lines 5 Trench Width 24" Max Trench Bottom Depth 36"

☑ New System ☐ Repair ☐ Expansion System Type: I II III IV V VI
System Description: LP PPBPS
Repair System Description: existing bed (3 bedrooms) reclaimed as 2 bedrooms
Maintenance Agreement Required: ☑ Yes ☐ No

☑ House/Mod. Home No. Bedrooms 4
☐ Mobile Home No. Persons
☐ Business No. Employees
☐ Other


Water Supply: ☑ Individual ☐ Public ☐ Community

Gravel Depth — ☐ Gravity ☑ Pressure ☐ Slab ☐ Crawl Space ☑ Basement w/plumbing ☐ Basement wo/plumbing


Comments:/Conditions:
* Use existing Tank, add pump tank
* Install on Contour & maintain Setbacks
* Some existing bed system to be used for repair of 2 bdrs w/ a little repair above

Comments:/Conditions:

INITIAL SITE SKETCH

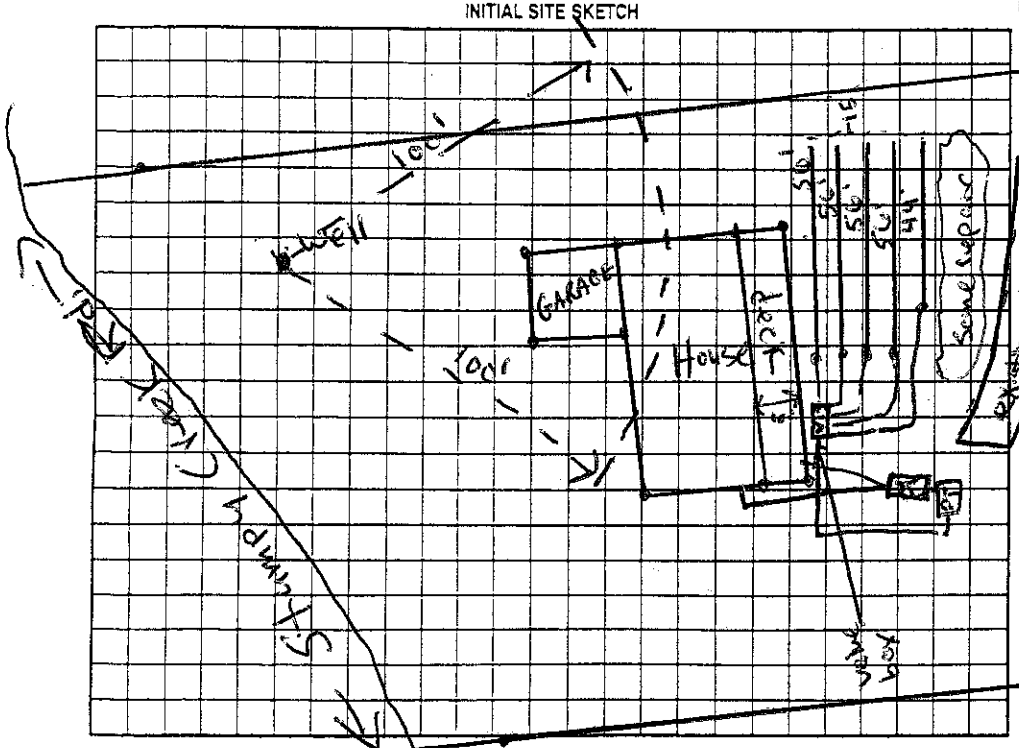

AS BUILT SKETCH

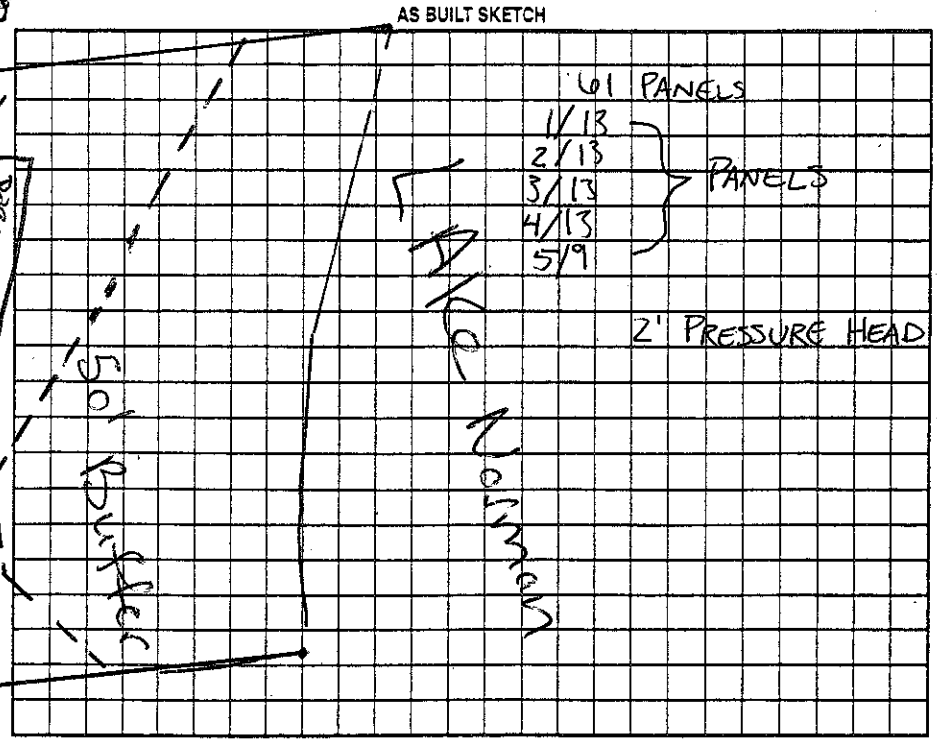

Permit can be suspended or revoked if any false information is supplied toward securing the permit/any unauthorized changes are made to the site/any unauthorized changes are made in the installation of the system. Improvement Permit with plan valid without expiration ☐ Improvement Permit with site plan valid for sixty months ☑ Authorization to Construct is valid for a period equal to that of Improvement Permit – not to exceed sixty months.

Signed: Chad Young date 10-6-08 Installed by: LARRY BEAM

Improvement Permit by: Randy Moore date 9/29/08 Operation Permit by: date 6-24-09

Authorization to Construct by: Randy Moore date 9/29/08 Existing System Inspection by: date

HEALTH DEPT. COPY: WHITE OWNER COPY (FINAL): YELLOW OWNER COPY (INITIAL): PINK