2:00

IREDELL COUNTY HEALTH DEPARTMENT

STATESVILLE 704-878-5305 MOORESVILLE 704-664-5281

IMPROVEMENT PERMIT / AUTHORIZATION TO CONSTRUCT / OPERATION PERMIT / EXISTING SYSTEM INSPECTION

PERMIT# 111536 PIN# ~~4659 60 1010, 1042~~ 4638598962.000 DATE 3/18/03

OWNER OR CONTRACTOR Crescent Resources / John Preston Hompson PHONE: Business 704-663-6905 Home

ADDRESS PO Box 396 Terrell NC 28682

LOCATION 150 W, TR Perth, TL Stumpy Crk Near End on Lt

SUBDIVISION CL+T BLOCK / SECTION 4 LOT 1042 LOT AREA 0.689 Ac SITE CLASS. PS DESIGN FLOW 360 L.T.A.R. 0.3

Septic Tank: 1000 Gallons; STB 1007 Date 8-17-04

Pump Tank: 1000 Gallons; PT 274 Date 8-5-04

Pump Make: Model Serial No.

Nitrification Field: No Fields 1 Square Feet 600 Linear Feet 200

No Lines 3 Trench Width 24"-36" Max Trench Bottom Depth 36" Gravel Depth —

☒ New System ☐ Repair System Type: I, II, III, (IV), V, VI

System Description: 20 Panel Block

Repair System Description: Same

Maintenance Agreement Required: ~~☒~~ Yes ☐ No

☒ House/Mod. Home ☐ Mobile Home ☐ Business ☐ Other

No. Bedrooms 3 No. Bathrooms 3 No. Employees

☐ Slab ☒ Crawl Space ☐ Basement w/plumbing ☐ Basement wo/plumbing

Water Supply: ☒ Individual ☐ Public ☐ Community


Comments:/Conditions:

Comments:/Conditions:


Switching tanks @ well Run

Checked tanks 10/12/04 MD

INITIAL SITE SKETCH 1"=50'

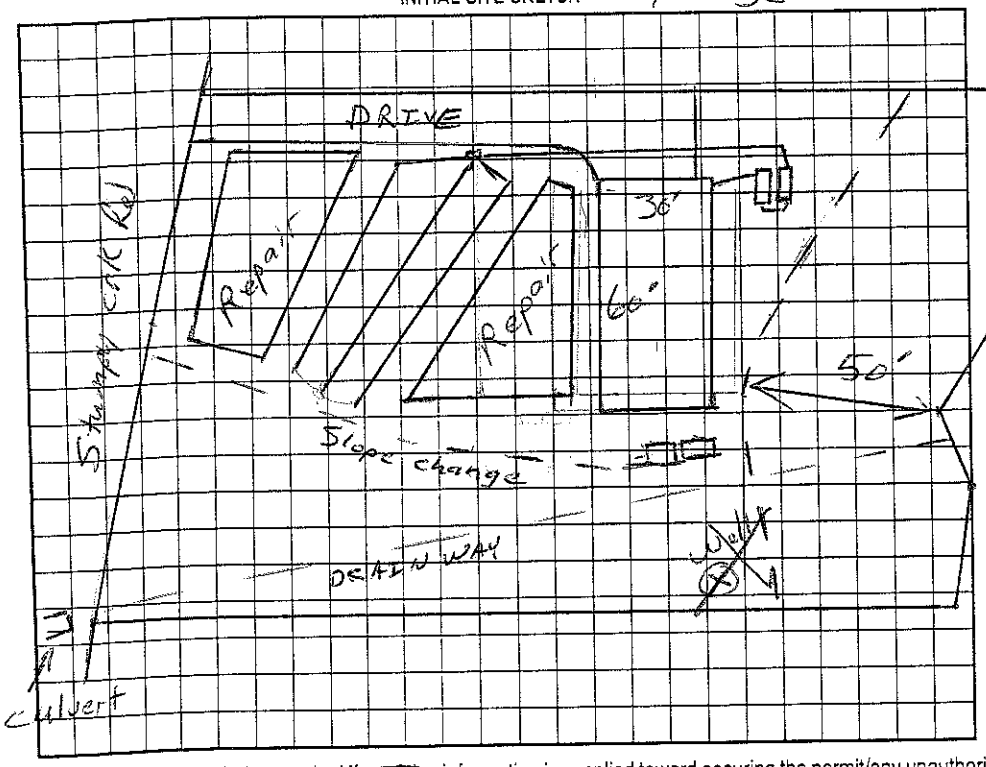

AS BUILT SKETCH

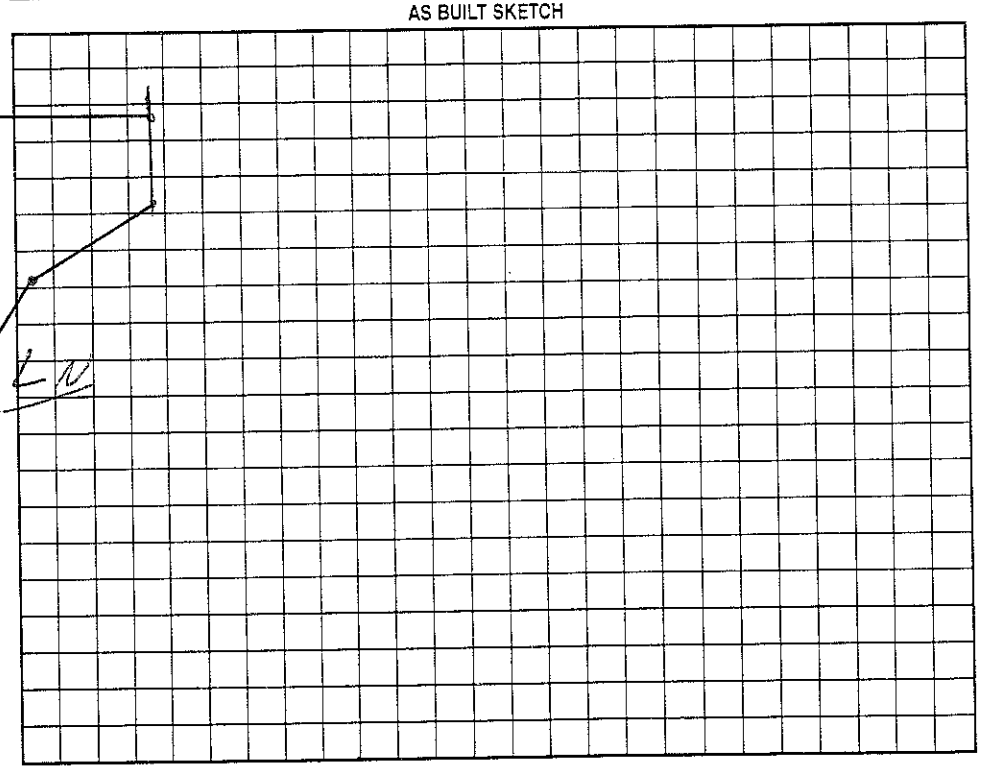

Permit can be ~~suspended~~ or ~~revoked~~ if any false information is supplied toward securing the permit/any unauthorized changes are made to the site/any unauthorized changes are made in the installation of the system. Improvement Permit with plat valid without expiration. Improvement Permit with site plan valid for sixty months. Authorization to Construct is valid for a period equal to that of Improvement Permit – not to exceed sixty months.

Signed: date 3/18/03

Improvement Permit by: RS date 3/18/03

Authorization to Construct by: RS date 5/6/04

Installed by: Wayne Lantz

Operation Permit by: RS date 7/5/05

Existing System Inspection by: date

HEALTH DEPT. COPY: WHITE OWNER COPY (FINAL): YELLOW OWNER COPY (INITIAL): PINK