IREDELL COUNTY HEALTH DEPARTMENT

STATESVILLE 704-878-5305 MOORESVILLE 704-664-5281

IMPROVEMENT PERMIT / AUTHORIZATION TO CONSTRUCT / OPERATION PERMIT / EXISTING SYSTEM INSPECTION

PERMIT# 25002 PIN# 2P-4-A-195 4638-62-5997 DATE 3/16/98

OWNER OR CONTRACTOR WALTER SMITH PHONE: Business Home

ADDRESS PO BOX 141 MOORESVILLE NC 28115

LOCATION PERTH RD TO CATAWBA IR ~1000' ON RT

SUBDIVISION LNAP BLOCK / SECTION S LOT 40 LOT AREA 1.39AC SITE CLASS. 05 DESIGN FLOW 480GPD L.T.A.R. .30 GPD/FT²

Septic Tank: 1000 Gallons; STB 825 Date 6/11/98

Pump Tank: Gallons; PT Date

Pump Make: Model Serial No.

Nitrification Field: No Fields 1 Square Feet 1600 Linear Feet 533

No Lines 4 @ 133' Trench Width 36" Max Trench Bottom Depth 36" Gravel Depth 12"

☑ New System ☐ Repair System Type: I, II, III, IV, V, VI

System Description: GRAVITY CONVENTIONAL

Repair System Description: PLANE C

Maintenance Agreement Required: ☐ Yes ☑ No

☑ House/Mod. Home ☐ Mobile Home ☐ Business ☐ Other

No. Bedrooms 4/3 No. Bathrooms 3.5 No. Employees

☐ Slab ☐ Crawl Space ☑ Basement w/plumbing ☐ Basement wo/plumbing


Water Supply: ☑ Individual ☐ Public ☐ Community

Comments:/Conditions:

301'


1" = 50'

INITIAL SITE SKETCH

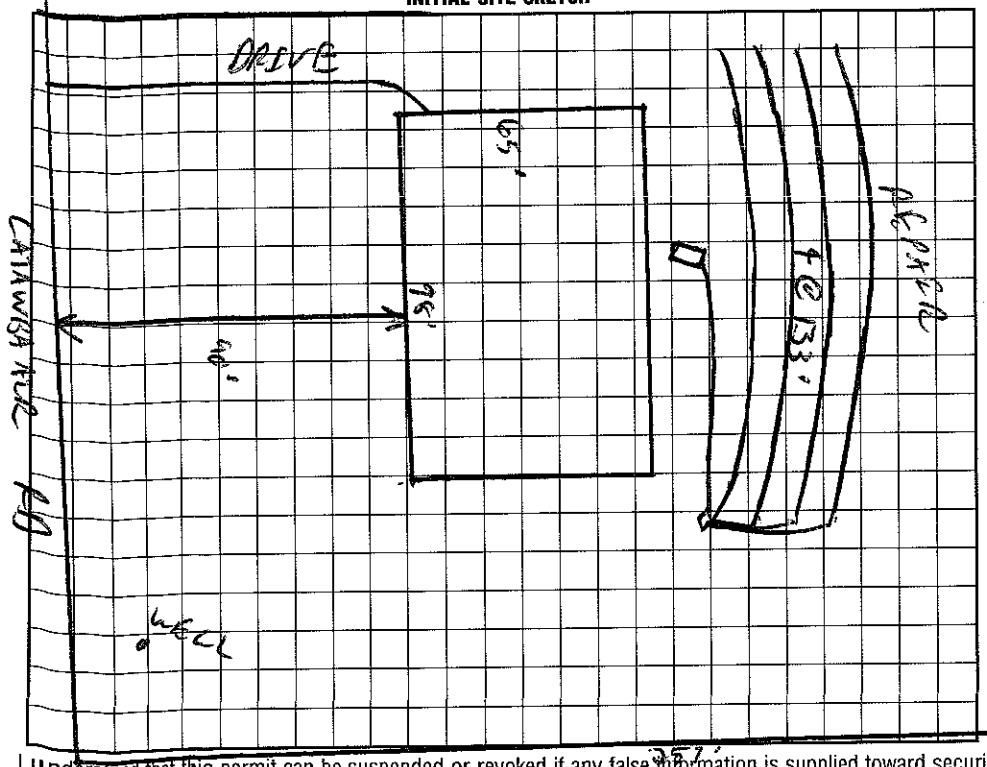

Comments:/Conditions:

AS BUILT SKETCH

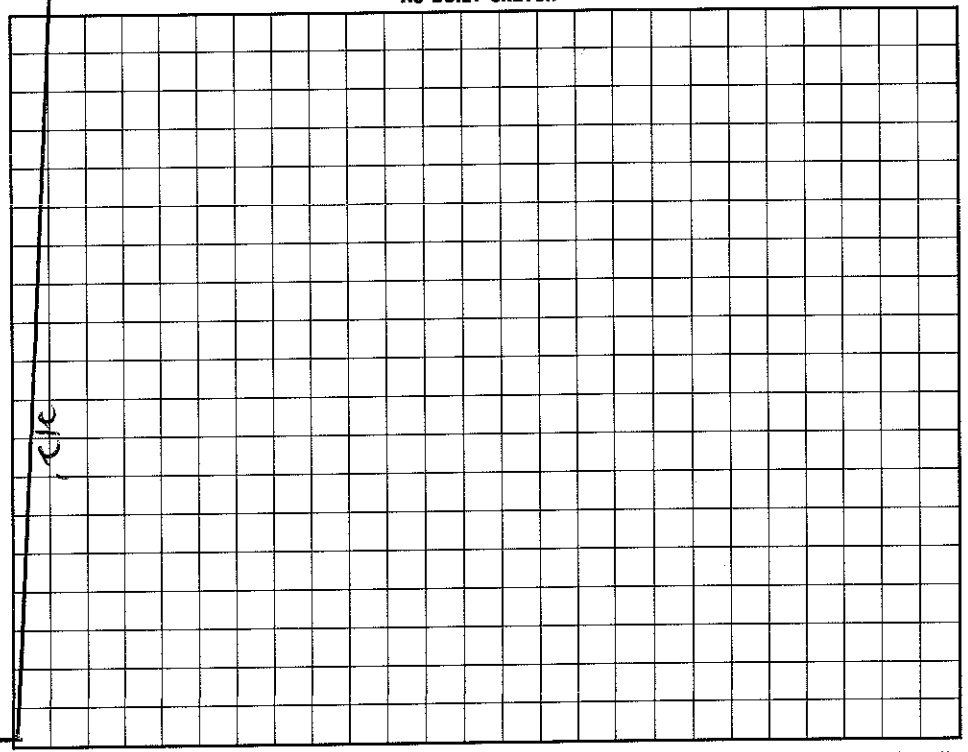

I understand that this permit can be suspended or revoked if any false information is supplied toward securing the permit/any unauthorized changes are made to the site/any unauthorized changes are made in the installation of the system. Improvement Permit with plat valid without expiration. Improvement Permit with site plan valid for sixty months. Authorization to Construct is valid for a period equal to that of Improvement Permit – not to exceed sixty months.

Signed: date 3/17/98 Installed by: DELBERT BOSTIAN date 9/3/98

Improvement Permit by: RS date 3/16/98 Operation Permit by: date

Authorization to Construct by: RS date 3/16/98 Existing System Inspection by: date

HEALTH DEPT. COPY: WHITE INSPECTION COPY (FINAL): GREEN OWNER COPY (FINAL): YELLOW INSPECTION COPY (INITIAL): PINK OWNER COPY (INITIAL): GOLD