IREDELL COUNTY HEALTH DEPARTMENT

STATESVILLE 704-878-5305 MOORESVILLE 704-664-5281

IMPROVEMENT PERMIT / CERTIFICATE OF COMPLETION / OPERATION PERMIT / EXISTING SYSTEM INSPECTION

PROPERTY DESCRIPTION NO. 20441 DATE 3/6/95 TAX MAP NO. 2P 4A 207 4638 62 7114 Watershed: ☐ Yes ☑ No

OWNER OR CONTRACTOR Peter Deatherage PHONE: Business _____ Home 892-4826

ADDRESS PO Box 2142 Cornelius, NC. 28031

LOCATION Beth. Rd. N TL Catawba Air Rd. TL Yeager on left 100 Yards 117 Yeager

SUBDIVISION LN AIRPARK BLOCK / SECTION _____ LOT 2 LOT AREA .98 Ac SITE CLASS. P DESIGN FLOW _____ L.T.A.R. .3

Septic Tank: 1000 Gallons; STB 794 Date 8/95 ☑ New System ☐ Repair System Type: I, II, (III), IV, V, VI

Pump Tank: 1000 Gallons; PT 49 Date 8/15/95 System Description: Pressure - Conventional

Pump Make: LIBERTY Model LES1A Serial No. 12462 Repair System Description: _____

Nitrification Field: No Fields Square Feet 720 Linear Feet ~~240~~ 160 Maintenance Agreement Required: ☐ Yes ☑ No

No Lines ~~4~~ 2 Trench Width 36" Max Trench Bottom Depth 30" Gravel Depth 12" ☑ Slab ☐ Crawl Space ☐ Basement w/plumbing ☐ Basement wo/plumbing

☐ House/Mod. Home No. Bedrooms _____

☐ Mobile Home No. Bathrooms _____

☒ Business No. Employees 4


☑ Other 80'x125' HANGAR

Water Supply: ☑ Individual ☐ Community ☐ Public


Comments: Tank location chgs. ok'd - 8/29/95 Rms
Building shifted on site to accomodate tanks on (R) side of bldg.

Comments: Installed as drawn on I. P.

INITIAL SITE SKETCH

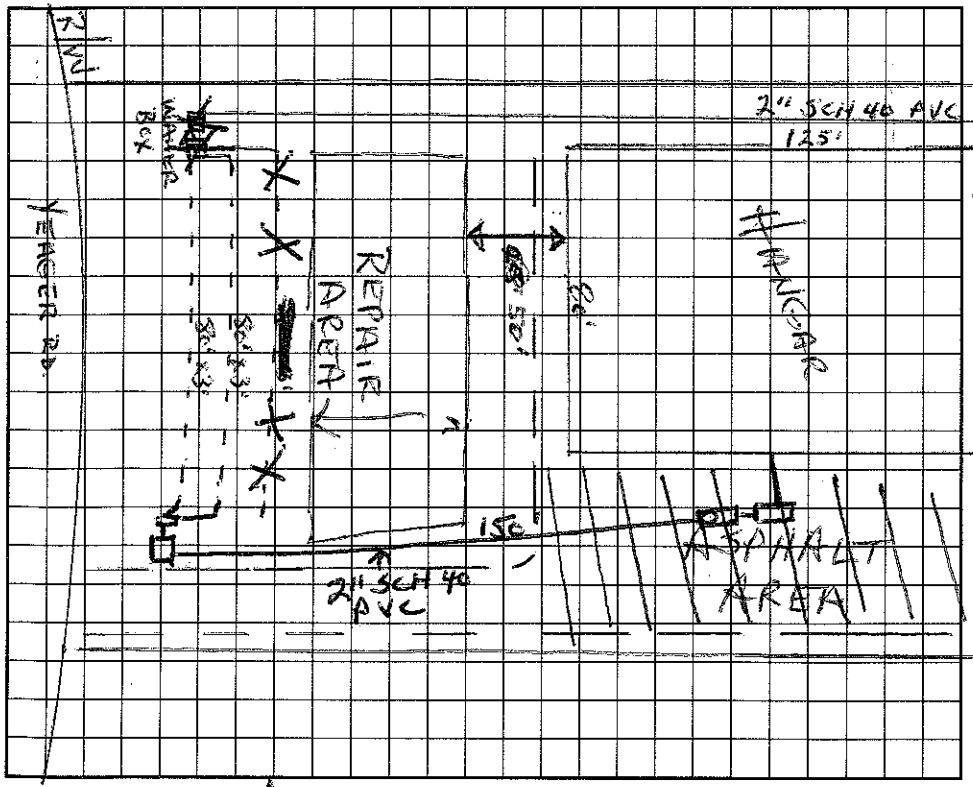

AS BUILT SKETCH

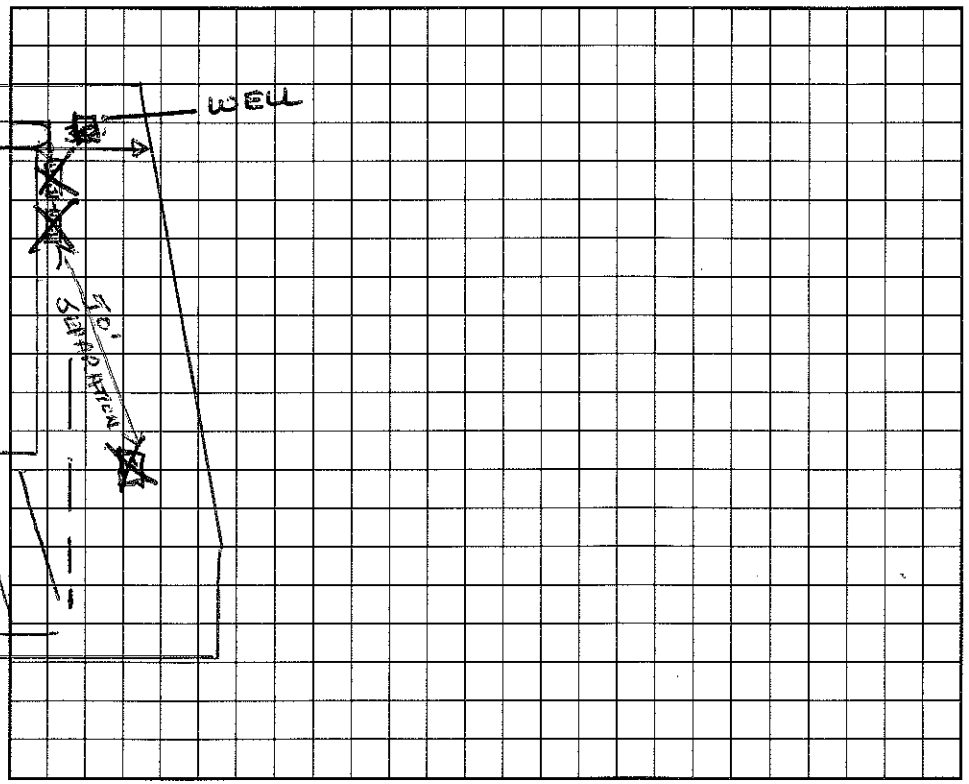

I understand that this permit can be suspended or revoked if any false information is supplied toward securing the permit/any unauthorized changes are made to the site/any unauthorized changes are made in the installation of the system. Improvement Permit is valid for 60 months from date of issuance.

Signed: _____

Improvement Permit by: Wesley Sparks RS. date 3/6/95

Existing System Inspection by: _____ date _____

Installed by: Richard Brown

Certificate of Completion by: Wesley Sparks RS. date 1/19/96

Operation Permit by: Wesley Sparks RS. date 1/19/96

HEALTH DEPT. COPY: WHITE INSPECTION COPY (FINAL): GREEN OWNER COPY (FINAL): YELLOW INSPECTION COPY (INITIAL): PINK OWNER COPY (INITIAL): GOLD