IREDELL COUNTY HEALTH DEPARTMENT

STATESVILLE 704-878-5305 50.00 Paid MOORESVILLE 704-664-5281

IMPROVEMENT PERMIT / AUTHORIZATION TO CONSTRUCT / OPERATION PERMIT / EXISTING SYSTEM INSPECTION

PERMIT# 072789 PIN# 4638 63 2320 DATE 5/10/04

OWNER OR CONTRACTOR James Slate PHONE: Business 704-906-1558 Home

ADDRESS 172 Catawba Rim Rd Mooresville, NC. 28117

LOCATION Perth Rd. TL Catawba Rim Rd. to cul de sac, last house

SUBDIVISION LNIAP BLOCK / SECTION LOT 42 LOT AREA ~1.24 Ac SITE CLASS. PS DESIGN FLOW 480 L.T.A.R. .3

Septic Tank: 1550 Gallons; STB 190 Date 1/5/04
Pump Tank: Gallons; PT Date
Pump Make: Model Serial No.
Nitrification Field: No Fields 1 Square Feet 1200 Linear Feet 400±
No Lines 10 100' Trench Width 3' Max Trench Bottom Depth 3' Gravel Depth No


[X] New System [ ] Repair System Type: I, II, III, IV, V, VI
System Description: Type 3 - 25% Reduced
Repair System Description: 16" PPBPS
Maintenance Agreement Required: [ ] Yes [X] No

[X] House/Mod. Home No. Bedrooms 4
[ ] Mobile Home No. Bathrooms 3.5
[ ] Business No. Employees
[ ] Other
[ ] Slab [ ] Crawl Space [X] Basement w/plumbing [ ] Basement wo/plumbing

Water Supply: [X] Individual [ ] Public [ ] Community


Comments:/Conditions 1" = 50'

INITIAL SITE SKETCH

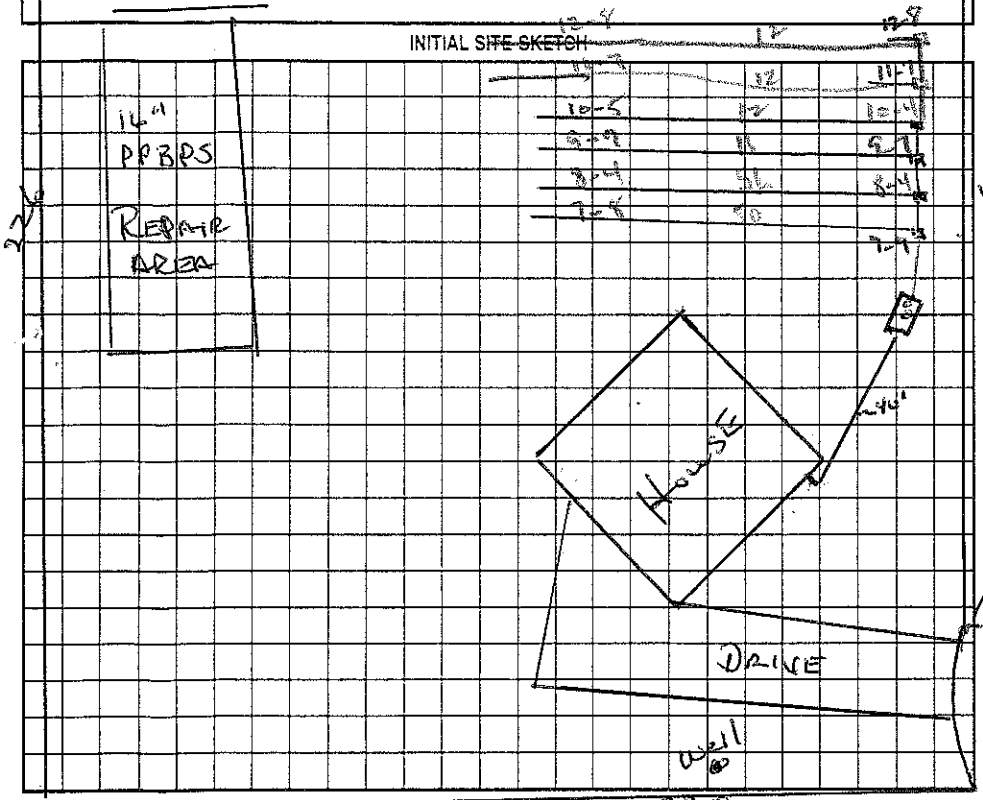

Comments:/Conditions:

AS BUILT SKETCH

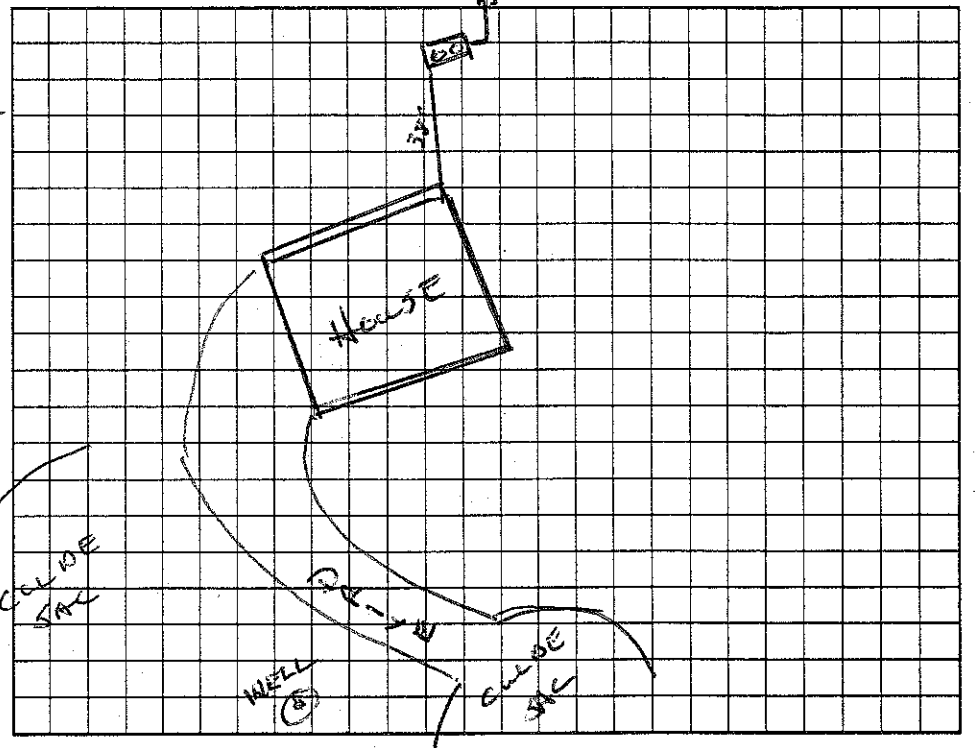

Permit can be suspended or revoked if any false information is supplied toward securing the permit/any unauthorized changes are made to the site/any unauthorized changes are made in the installation of the system. Improvement Permit with plat valid without expiration. Improvement Permit with site plan valid for sixty months. Authorization to Construct is valid for a period equal to that of Improvement Permit – not to exceed sixty months.

Signed: * James L. Slate date 5/10/04

Improvement Permit by: Wesley Sparks RS. date 5/10/04

Authorization to Construct by: Wesley Sparks RS date 5/10/04

Installed by: Leathermans Septic Tank

Operation Permit by: Wesley Sparks RS. date 5/24/04

Existing System Inspection by: date

HEALTH DEPT. COPY: WHITE OWNER COPY (FINAL): YELLOW OWNER COPY (INITIAL): PINK