IREDELL COUNTY HEALTH DEPARTMENT

STATESVILLE 704-878-5305 — D — MOORESVILLE 704-664-5281

IMPROVEMENT PERMIT / AUTHORIZATION TO CONSTRUCT / OPERATION PERMIT / EXISTING SYSTEM INSPECTION

PERMIT# 122999 PIN# 4638 63 4444 DATE 8-26-04

OWNER OR CONTRACTOR Bruce Allen (or Nancy Shore) / Kent Stewart Sons Const PHONE: Business (704) 798-5216 Home (704) 278-4352

ADDRESS 1425 Godbey Rd Salisbury, NC 28147

LOCATION Perth Rd North TL Normandy on left ~ 200 yds

SUBDIVISION LNAP BLOCK / SECTION F LOT 57 LOT AREA 1.42 Acre SITE CLASS. PS DESIGN FLOW 480 gpd L.T.A.R. .3

Septic Tank: 1000 Gallons; STB 794 Date 1-23-07

Pump Tank: _____ Gallons; PT _____ Date _____

Pump Make: _____ Model _____ Serial No. _____

Nitrification Field: No Fields 1 Square Feet 1590' Linear Feet 530'

No Lines 5@106' Trench Width 36" Max Trench Bottom Depth 24" Gravel Depth 12"

☒ New System ☐ Repair System Type: I, II, III, IV, V, VI

System Description: Gravity - Conventional

Repair System Description: Gravity - 25% Reduction

Maintenance Agreement Required: ☐ Yes ☒ No

☒ House/Mod. Home ☐ Mobile Home ☐ Business ☐ Other

No. Bedrooms 4 No. Bathrooms 4 No. Employees _____


☐ Slab ☒ Crawl Space ☐ Basement w/plumbing ☐ Basement wo/plumbing

Water Supply: ☒ Individual ☐ Public ☐ Community


Comments:/Conditions: Keep Septic System at least 10' from PL.
* Best if 25% Reduct. System Installed
* Front Load Garage

Comments:/Conditions: * Keep System Shallow ≤ 24"
Shallow Soils
Keep well 50-100' to Septic System.

INITIAL SITE SKETCH Scale 1:100

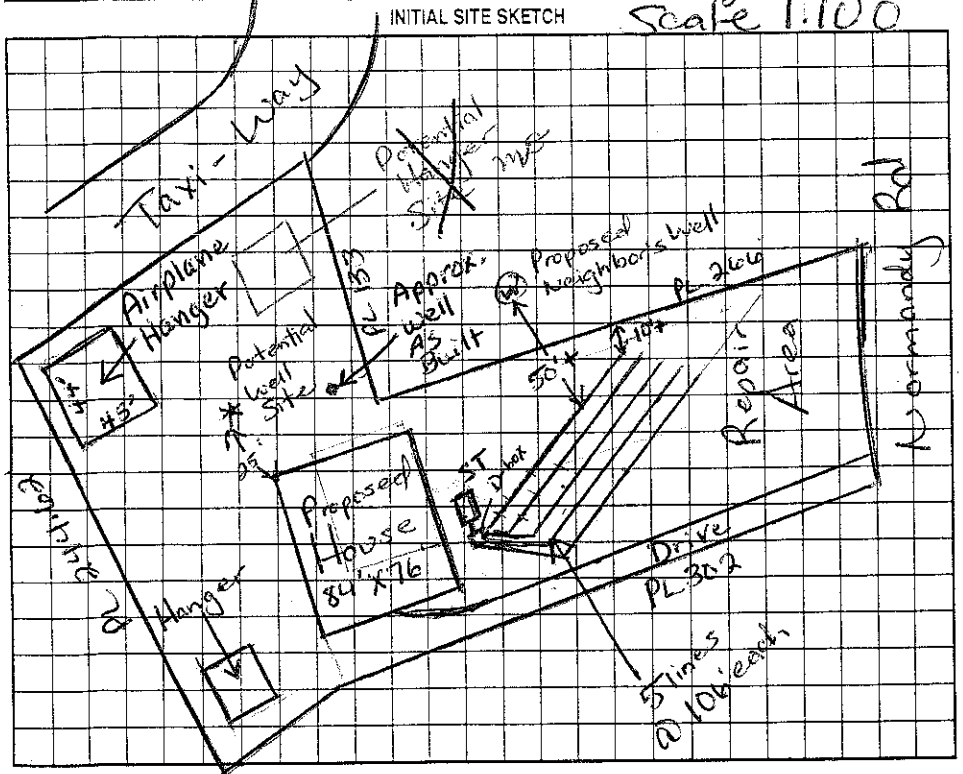

AS BUILT SKETCH (NTS)

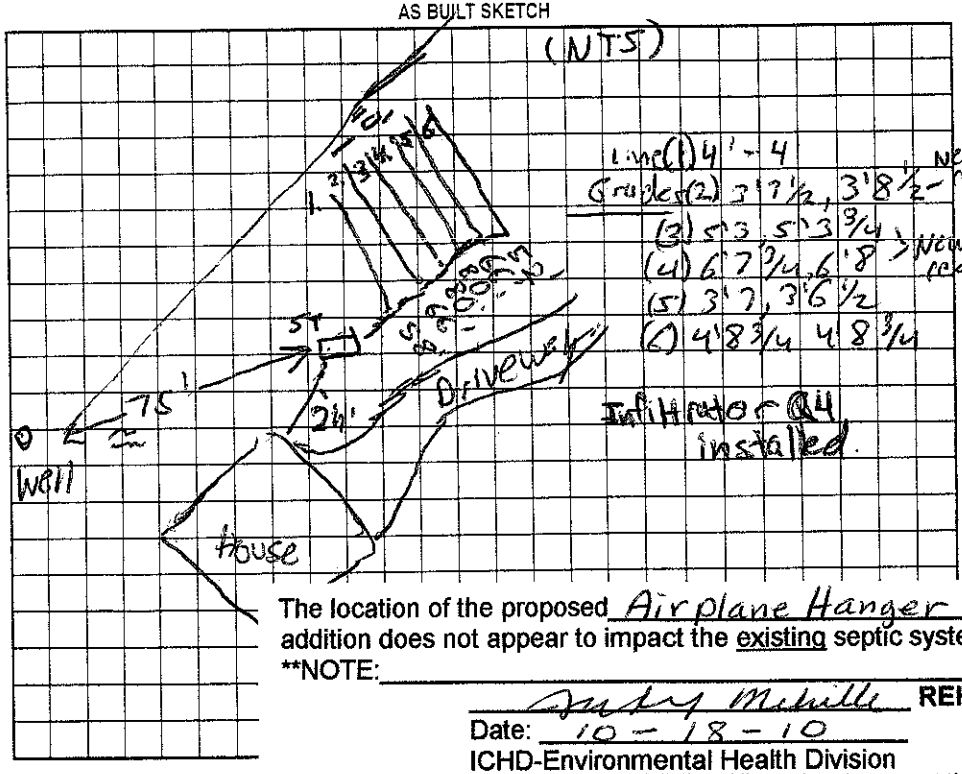

The location of the proposed Airplane Hanger addition does not appear to impact the existing septic system.

**NOTE: _____

Suzy Melville REHS

Date: 10-18-10

ICHD-Environmental Health Division

Permit can be suspended or revoked if any false information is supplied toward securing the permit/any unauthorized changes are made to the site/any unauthorized changes are made in the installation of the system. Improvement Permit with plat valid without expiration. Improvement Permit with site plan valid for sixty months. Authorization to Construct is valid for a period equal to that of Improvement Permit – not to exceed sixty months.

Signed: R. Shore date 8-27-04 Installed by: Richard Abernathy

Improvement Permit by: Mairs H. Dotson RS date 8/26/04 Operation Permit by: Anthony Cohen / Steve Gray RS LSS date 5/30/07

Authorization to Construct by: RS date 8/30/06 Existing System Inspection by: _____ date _____

HEALTH DEPT. COPY: WHITE OWNER COPY (FINAL): YELLOW OWNER COPY (INITIAL): PINK