IREDELL COUNTY HEALTH DEPARTMENT

STA[illegible]LE 704-878-5305 MOORESVILLE 704-664-5281

IMPROVEMENT PERMIT / AUTHORIZATION TO CONSTRUCT / OPERATION PERMIT / EXISTING SYSTEM INSPECTION

PERMIT# 120814 PIN# 4638-63-4854 DATE

OWNER OR CONTRACTOR Gavin Houchins PHONE: Business Home 704-947-9869

ADDRESS 7604 Henderson Pk Rd Huntersville NC 28078

LOCATION 150 W TR Perth, TL Normandy, on Lt before Hughes Ln

SUBDIVISION LNAP BLOCK / SECTION LOT 47 LOT AREA 1.42 Ac SITE CLASS. PS DESIGN FLOW 480 L.T.A.R. 0.3

Septic Tank: 1000 Gallons; STB 794 Date 9/29/05

Pump Tank: Gallons; PT Date

Pump Make: Model Serial No.

Nitrification Field: No Fields 1 Square Feet ~~1000~~/1200 Linear Feet ~~500~~ 400

No Lines ~~400'~~ Trench Width 36" Max Trench Bottom Depth 36"

☒ New System ☐ Repair System Type: I, II, III, IV, V, VI

System Description: Grav. ~~Conventional~~ 25% Repair System Description: 25% Reduction

Maintenance Agreement Required: ☐ Yes ☒ No

☒ House/Mod. Home No. Bedrooms 4

☐ Mobile Home No. Bathrooms 4

☐ Business No. Employees

☐ Other


Gravel Depth 12" ☐ Slab ☒ Crawl Space ☐ Basement w/plumbing ☐ Basement wo/plumbing

Water Supply: ☒ Individual ☐ Public ☐ Community


Comments/Conditions: 4 @ 100'

Comments/Conditions: House can move towards the Road 10'-15'.

INITIAL SITE SKETCH

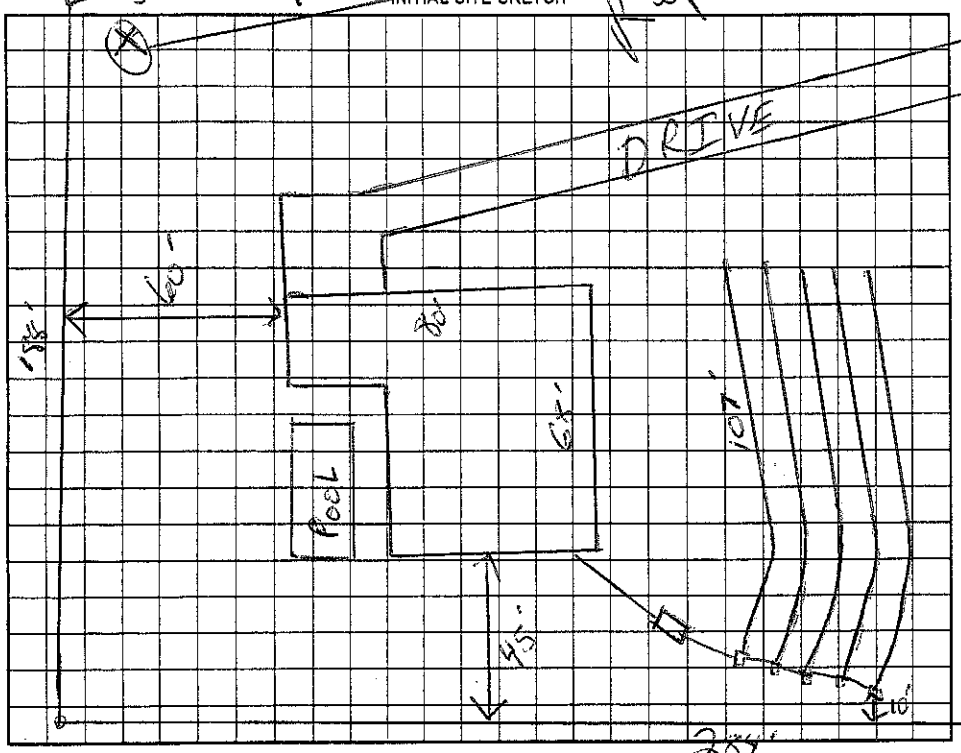

AS BUILT SKETCH

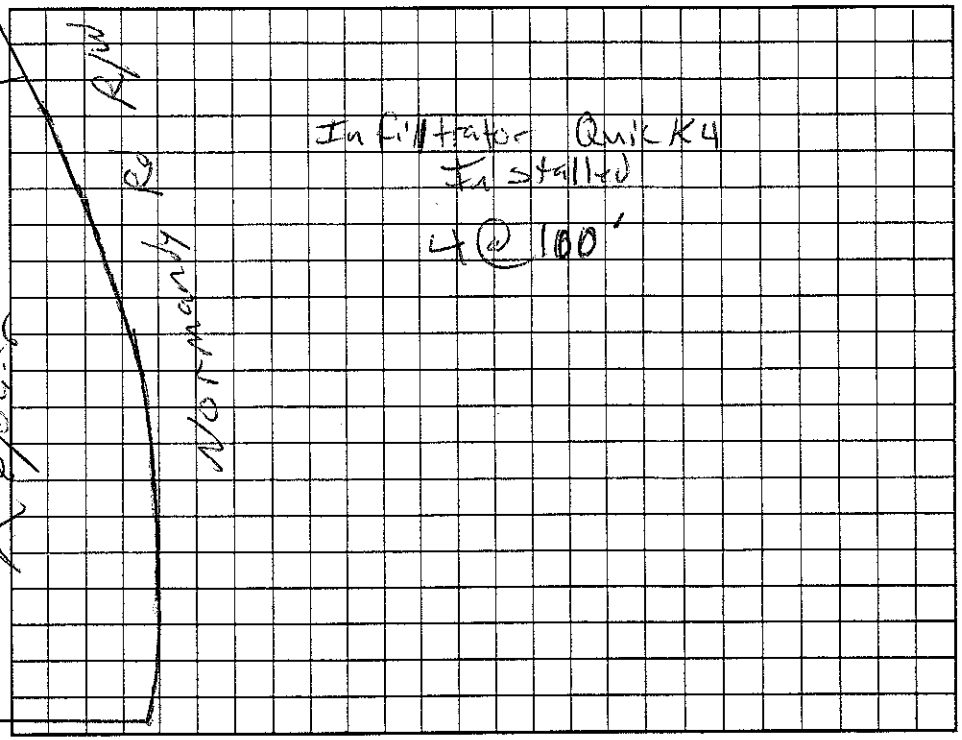

Permit can be suspended or revoked if any false information is supplied toward securing the permit/any unauthorized changes are made to the site/any unauthorized changes are made in the installation of the system. Improvement Permit with plat valid without expiration. Improvement Permit with site plan valid for sixty months. Authorization to Construct is valid for a period equal to that of Improvement Permit – not to exceed sixty months.

Signed: date 6-16-04 Installed by: Bob McCarver

Improvement Permit by: date 6/16/04 Operation Permit by: date 11/2/05

Authorization to Construct by: date 6/16/04 Existing System Inspection by: date

HEALTH DEPT. COPY: WHITE OWNER COPY (FINAL): YELLOW OWNER COPY (INITIAL): PINK