IREDELL COUNTY HEALTH DEPARTMENT

STATESVILLE 704-878-5305 MOORESVILLE 704-664-5281

IMPROVEMENT PERMIT / AUTHORIZATION TO CONSTRUCT / OPERATION PERMIT / EXISTING SYSTEM INSPECTION

PERMIT # 158819 PIN # 4658-65-5624 DATE 12-4-09

OWNER or APPLICANT HOLIDAY OBRECHT PHONE: Business 704-528-4494 Home: KENT SHAW

OWNER or APPLICANT ADDRESS [redacted] 165 NORMANDY RD

LOCATION / DIRECTIONS PERTH, TL NORMANDY, 165 ON L

SUBDIVISION LAKE NORMAN AIR PARK BLOCK / SECTION LOT # 56 LOT AREA 1.42 DESIGN FLOW 480 GPD L.T.A.R. .35

Septic Tank 1000 Gallons: STB 794 Date 5-9-10

Pump Tank Gallons: P T Date

Pump Make Model Serial #

Nitrification Field No Fields 1 No Lines 4 Linear Feet 340'

Trench Width 36" Max. Trench Bottom Depth 36" Gravel Depth — GRAVITY PRESSURE

☒ New System ☐ Repair ☐ Expansion System Type I (II) III IV V VI

System Description: GRAVITY CONVENTIONAL 25%

Repair System Description: [redacted] LP PANEL BLOCK

Maintenance Agreement Required ☐ YES ☒ NO INITIALLY


☒ Residence No. Bedrooms 4 ☐ Business No. Persons ☐ Other No. Employees ☐ Slab ☒ Crawl Space ☐ Basement w/plumbing ☐ Basement w/o plumbing

Water Supply: ☒ Private ☐ Public ☐ Community

Comments / Conditions: 1) MUST BE MIN OF 100' BETWEEN WELL + SYSTEM 2) IF CHAMBERS ARE USED, END CAPS MAY BE USED

Comments / Conditions * 3 BED ROOM HOUSE BUT 4 BROOM SYSTEM FOR FUTURE USE *

INITIAL SITE SKETCH

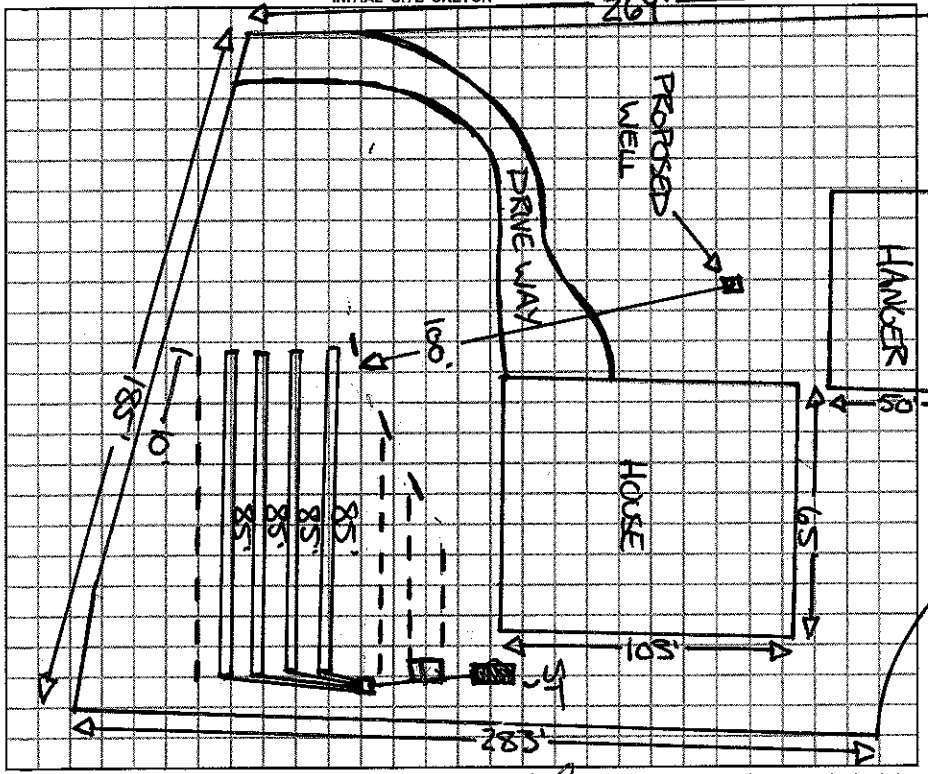

AS BUILT SKETCH

* NOT TO SCALE *

ARC 36 USED

CHECKED ON 6-17-10 W/ RICHARD A LINES MAY HAVE TO GO DIAGONALLY BECAUSE OF TOPO CHANGE

LINES INSTALLED AS SHOWN BUT MORE OF AN ANGLE

4C85'

Permit can be suspended or revoked if any false information is supplied toward securing the permit / any unauthorized changes are made to the site / any unauthorized changes are made in the installation of the system.

☐ IMPROVEMENT PERMIT w / plat valid without expiration. ☒ IMPROVEMENT PERMIT w / site plan valid for 60 mos. ☒ AUTHORIZATION TO CONSTRUCT valid for period equal to IMPROVEMENT PERMIT-not to exceed 60 mo.

Owner / Applicant Signature: [signature] Date 12-8-09

Improvement Permit by: B.A. REHS Date 12-4-09

Authorization to Construct by: B.A. REHS Date 12-4-09

Installed by: RICHARD ABERNATHY

Operation Permit by: B.A. REHS Date: 6-18-10

Existing System Inspected by: Date:

YOU SHOULD CONTACT A LOCATOR SERVICE PRIOR TO ANY EXCAVATION.

WHITE COPY Environmental Health YELLOW COPY (Final) Owner / Applicant PINK COPY (Initial) Owner / Applicant