IREDELL COUNTY HEALTH DEPARTMENT

STATESVILLE 704-878-5305 MOORESVILLE 704-664-5281

IMPROVEMENT PERMIT / CERTIFICATE OF COMPLETION / OPERATION PERMIT / EXISTING SYSTEM INSPECTION

PROPERTY DESCRIPTION NO. 074778/1183766 DATE 9/15/99 TAX MAP NO. 4634 63 7244 4638639154 Watershed: [X] Yes [ ] No

OWNER OR CONTRACTOR Ray Short / Pride Homes PHONE: Business 987-0278 Home

ADDRESS PO Box 3792 Mooresville, NC. 28117

LOCATION 150 W TR Perth Rd. TL Normandy Rd., 3RD house sit on (L)

SUBDIVISION Brand Bay BLOCK / SECTION 4 LOT 30 LOT AREA .64 SITE CLASS. PS DESIGN FLOW 360 L.T.A.R. .3

Septic Tank: 1000 Gallons; STB 1012 Date 3/3/04

Pump Tank: 1000 Gallons; PT 17 Date 3/24/04

Pump Make: Gould's Model WE0-511HH Serial No. A96TCA0467059

Nitrification Field: No Fields 1 Square Feet 900 Linear Feet 300

No Lines 4@75' Trench Width 36" Max Trench Bottom Depth 36" Gravel Depth SAND

[X] New System [ ] Repair System Type: I, II, [III] IV, V, VI

System Description: Pres. Man — HOS or Ch. Plastic

Repair System Description: ~~SAME~~ 16" PAB PS

Maintenance Agreement Required: [ ] Yes [X] No

[X] House/Mod. Home No. Bedrooms 3

[ ] Mobile Home No. Bathrooms 2

[ ] Business No. Employees

[ ] Other


[ ] Slab [X] Crawl Space [ ] Basement w/plumbing [ ] Basement wo/plumbing

Water Supply: [X] Individual [ ] Community [ ] Public


Comments:

Comments:

INITIAL SITE SKETCH

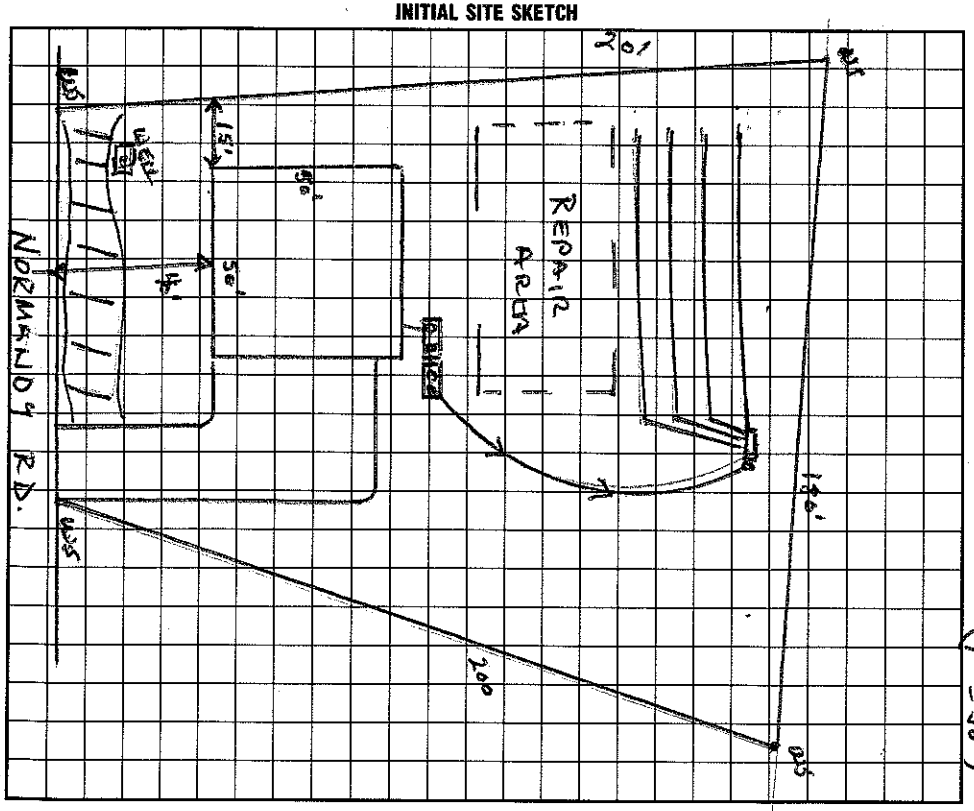

AS BUILT SKETCH

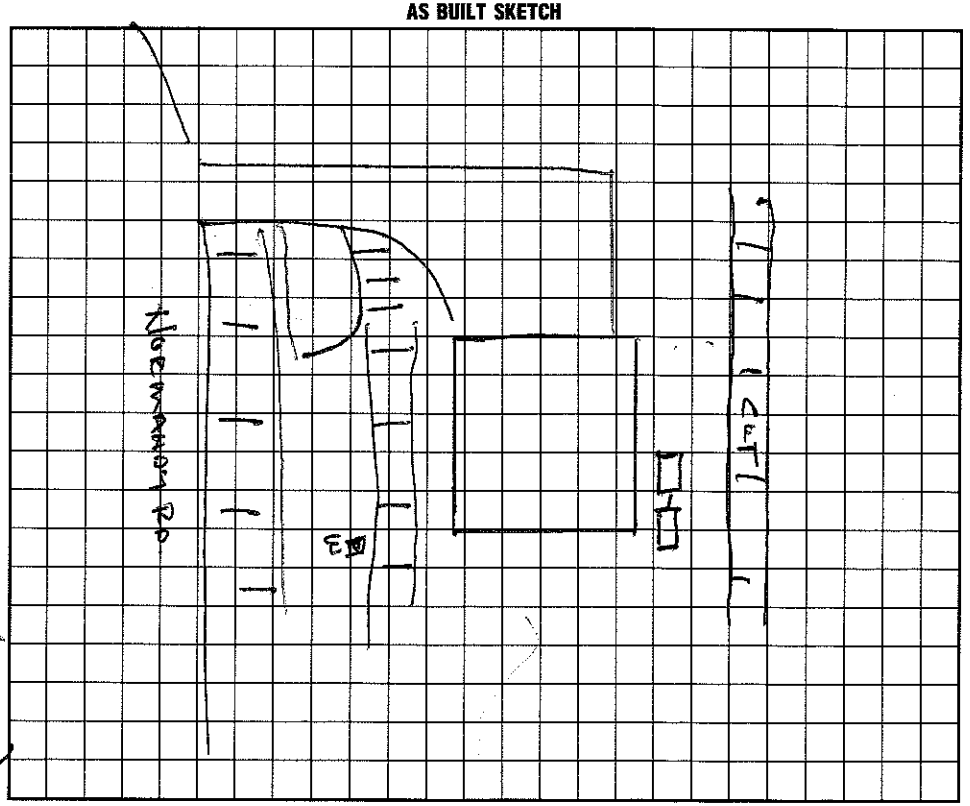

I understand that this permit can be suspended or revoked if any false information is supplied toward securing the permit/any unauthorized changes are made to the site/any unauthorized changes are made in the installation of the system. Improvement Permit is valid for 60 months from date of issuance.

Signed: X 9/15/99

Improvement Permit by: Wesley Parks RS. date 9/15/99

~~Existing System Inspection by:~~ RS date 1/14/04

AUTH CONSTR

Installed by: C+S Grading

Certificate of Completion by: Wesley Parks RS. date 8/13/04

Operation Permit by: date

HEALTH DEPT. COPY: WHITE INSPECTION COPY (FINAL): GREEN OWNER COPY (FINAL): YELLOW INSPECTION COPY (INITIAL): PINK OWNER COPY (INITIAL): GOLD