IREDELL COUNTY HEALTH DEPARTMENT

STATESVILLE 704-878-5305 MOORESVILLE 704-664-5281

IMPROVEMENT PERMIT / CERTIFICATE OF COMPLETION / OPERATION PERMIT / EXISTING SYSTEM INSPECTION

PROPERTY DESCRIPTION NO. 19483 DATE 4/27/95 TAX MAP NO. 2PA 14 4638-63-9453 Watershed: ☐ Yes ☑ No

OWNER OR CONTRACTOR Thomas Wilson Real Est. PHONE: Business Home 663-5115

ADDRESS P.H. 11 Mooresville, NC. 28115

LOCATION Nursery Rd. on (R) just past lake cove.

SUBDIVISION Grand Bay BLOCK / SECTION 1 LOT 1 LOT AREA 1.61 SITE CLASS. P DESIGN FLOW 480 L.T.A.R. .25

Septic Tank: 1000 Gallons; STB 794 Date 7/3/95

Pump Tank: 1000 Gallons; PT 27 Date 8/8/95

Pump Make: Model Serial No.

Nitrification Field: No. Fields 1 Square Feet 1920 Linear Feet *300

No. Lines 4 Trench Width 24" Max Trench Bottom Depth 36"

☑ New System ☐ Repair System Type: I, II, III, IV, V, VI

System Description: Press. Panel - 16"

Repair System Description: Same

Maintenance Agreement Required: ☑ Yes ☐ No

Gravel Depth 6" STONE ☐ Slab ☐ Crawl Space ☑ Basement w/plumbing ☐ Basement wo/plumbing

☑ House/Mod. Home No. Bedrooms 4

☐ Mobile Home No. Bathrooms 3

☐ Business No. Employees


☐ Other

Water Supply: ☑ Individual ☐ Community ☐ Public

Comments: *16" Pres. Panel

Comments:

INITIAL SITE SKETCH

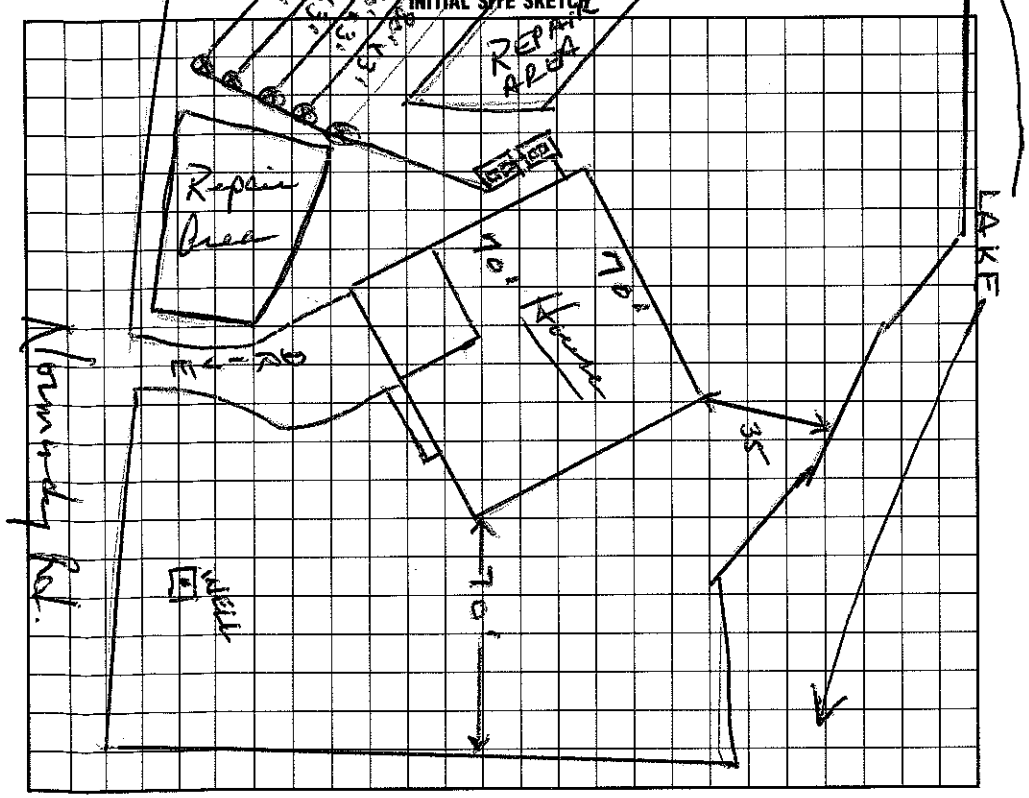

AS BUILT SKETCH

I understand that this permit can be suspended or revoked if any false information is supplied toward securing the permit/any unauthorized changes are made to the site/any unauthorized changes are made in the installation of the system. Improvement Permit is valid for 60 months from date of issuance.

Signed: Randy Murray

Improvement Permit by: Wesley Parks R.S. date 4/27/95

Existing System Inspection by: Construct Wesley Parks R.S. date 12/11/95

Installed by: F.J. Sawyer

Certificate of Completion by: Wesley Parks R.S. date 12/11/95

Operation Permit by: Wesley Parks R.S. date 12/11/95

HEALTH DEPT. COPY: WHITE INSPECTION COPY (FINAL): GREEN OWNER COPY (FINAL): YELLOW INSPECTION COPY (INITIAL): PINK OWNER COPY (INITIAL): GOLD