4638-64-3227

IREDELL COUNTY HEALTH DEPARTMENT

STATESVILLE 704-878-5305 MOORESVILLE 704-664-5281

IMPROVEMENT PERMIT / CERTIFICATE OF COMPLETION / OPERATION PERMIT / EXISTING SYSTEM INSPECTION

PROPERTY DESCRIPTION NO. 17606 DATE ~~2-17-93~~ 12/16/93 TAX MAP NO. 2P 4A 68

OWNER OR CONTRACTOR RANDY LAMBETH PHONE: Business Home 919-659-8776

ADDRESS 1088 Normandy Rd. Mooresville NC 28115

LOCATION Normandy Rd. / on (R) 2nd residential lot from Beth Rd.

SUBDIVISION ~~ENHAVEN~~ BLOCK / SECTION II LOT 1088 LOT AREA ~1.34C SITE CLASS. L.T.A.R.

CL & T

Water Supply: ☑ Individual ☐ Community ☐ Public

Septic Tank: 1000 Gallons; STB Date ORIGINAL (RANDY BARNES) 89

Pump Tank: 1000 Gallons; PT Date ORIGINAL

Nitrification Field: No Fields 1 Square Feet 900 Linear Feet 300

No Lines 4 Trench Width 3 Trench Depth 3' Gravel Depth 12"

☐ New System ☐ Repair System Type: I, II, III, IV, V, VI

System Description: Press - Conventional

Repair System Description:

Maintenance Agreement Required: ☑ Yes ☐ No

☑ House/Mod. Home ☐ Mobile Home ☐ Business ☐ Other

No. Bedrooms 3 No. Bathrooms 2.5 No. Employees

Garbage Disposal: ☑ Yes ☐ No

Auto. Dishwasher: ☑ Yes ☐ No


Auto. Washing Machine: ☑ Yes ☐ No

Other


☐ Slab ☑ Crawl Space ☐ Basement w/plumbing ☐ Basement wo/plumbing

Comments Recommend larger than 1000 gal. septic tank capacity to compensate for garbage disposal. Supply verified that needs to be cleaned in 3 years or greater. Inbound driveway crosses manifold.

INITIAL SITE SKETCH

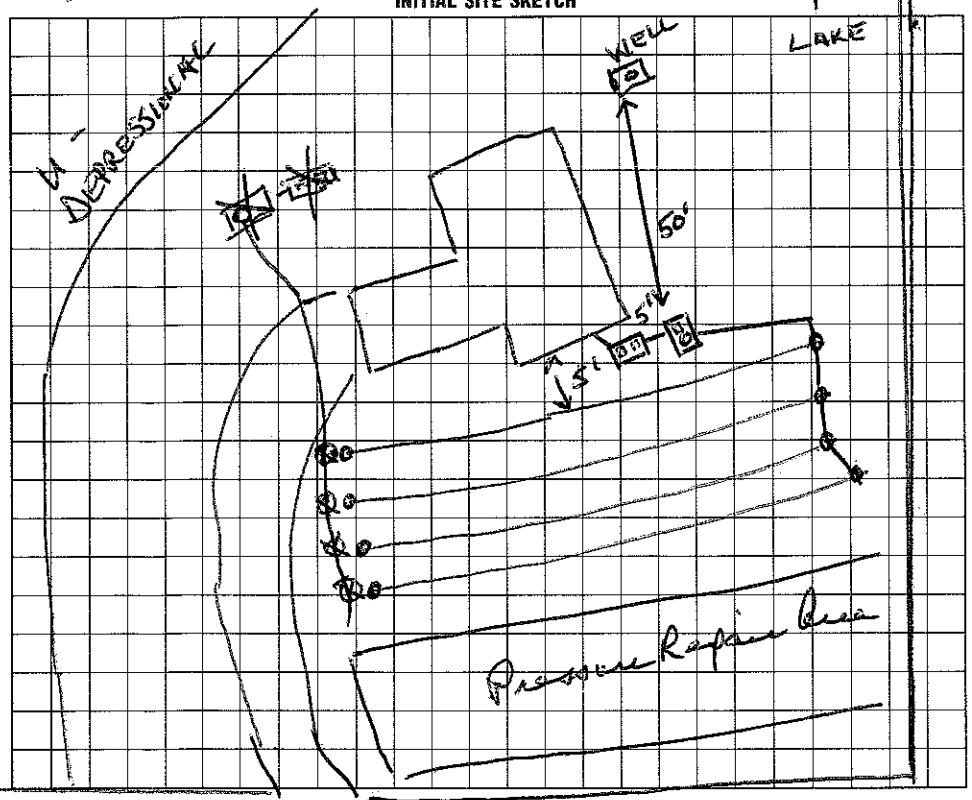

AS BUILT SKETCH

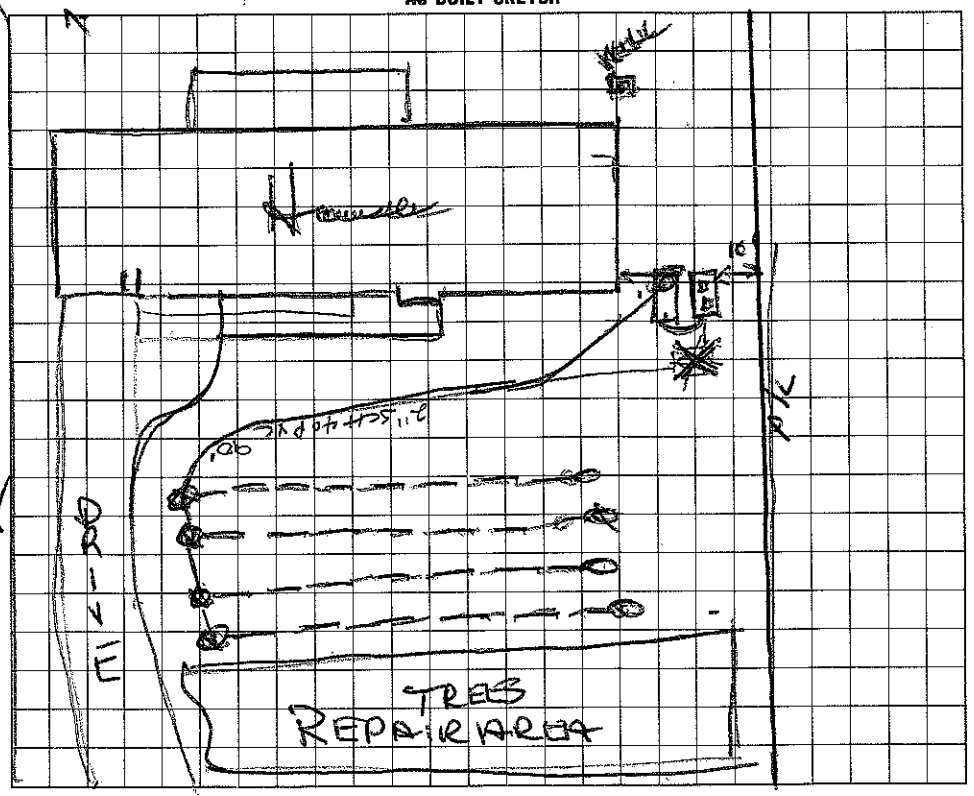

I understand that this permit can be suspended or revoked if any false information is supplied toward securing the permit/any unauthorized changes are made to the site/any unauthorized changes are made in the installation of the system. Improvement Permit is valid for 60 months from date of issuance. NORMANDY RD.

Signed:

Improvement Permit by: Wesley Sparks date 12/22/93

Existing System Inspection by: Wesley Sparks R.S. date 12/16/93

Installed by: F.T. Erwin

Certificate of Completion by: X date 4/25/94

Operation Permit by: X date

HEALTH DEPT. COPY: WHITE INSPECTION COPY (FINAL): GREEN OWNER COPY (FINAL): YELLOW INSPECTION COPY (INITIAL): PINK OWNER COPY (INITIAL): GOLD