ALP

IREDELL COUNTY HEALTH DEPARTMENT

Statesville Office (704) 878-5305 Mooresville Office (704) 660-3625 PERMIT # 205524

IMPROVEMENT PERMIT / AUTHORIZATION TO CONSTRUCT / OPERATION PERMIT / EXISTING SYSTEM

PIN # 4638-64-3570

APPLICANT: Steven Cook APPLICANT ADDRESS: 204 Normandy Rd 4638643570

SITE ADDRESS: Same PHONE: ALT. PHONE:

SITE DIRECTIONS: Perth, TL Normandy, on R

SUBDIVISION: Clet SECTION: 11 LOT # 70 LOT AREA: DESIGN FLOW: L.T.A.R.:

Septic Tank (gal) STB Date
Pump Tank (gal) PT Date
Pump Make Model Existing Serial #
Nitrification Fields # Lines Linear Ft:
Trench Width Max. Trench Bottom Depth Gravel Depth

☐ New System ☐ Repair ☐ Expansion System Type: I (II) III IV V VI
System Description: Gravel Bed
Repair System Description:
Maintenance Agreement Required: ☐ YES ☒ NO
☒ GRAVITY ☐ PRESSURE

☐ Residence No. Bedrooms
☐ Business No. Persons
☒ Other No. Employees
☐ Slab ☐ Crawl Space
☐ Basement w/plumbing ☐ Basement w/o plumbing

Water Supply
☐ Private
☐ Public
☐ Community

Comments / Conditions:

Sun Room

INITIAL SITE SKETCH

See Attached
Drawing By
ICHD
BA
APPROVED SEP 22 2014

AS BUILT SKETCH

Permit can be suspended or revoked if any false information is supplied toward securing the permit / any unauthorized changes are made to the site / any unauthorized changes are made in the installation of the system. **CONTACT A LOCATOR SERVICE PRIOR TO ANY EXCAVATION**


☐ **IMPROVEMENT PERMIT** *with plat valid without expiration.* ☐ **IMPROVEMENT PERMIT** *with site plan valid for 60 mos.* ☐ **AUTHORIZATION TO CONSTRUCT** *valid for period equal to IMPROVEMENT PERMIT--not to exceed 60 mo.*

Owner / Applicant Signature: Date: 9/25/14 Installed by:

IMPROVEMENT PERMIT by: Date: OPERATION PERMIT by: Date:

AUTHORIZATION TO CONSTRUCT by: Date: Existing System Inspected by: APPROVED Date: SEP 22 2014

Health Dept. Copy - WHITE Applicant (Final Approval) - YELLOW Applicant (Conditional Approval) - PINK

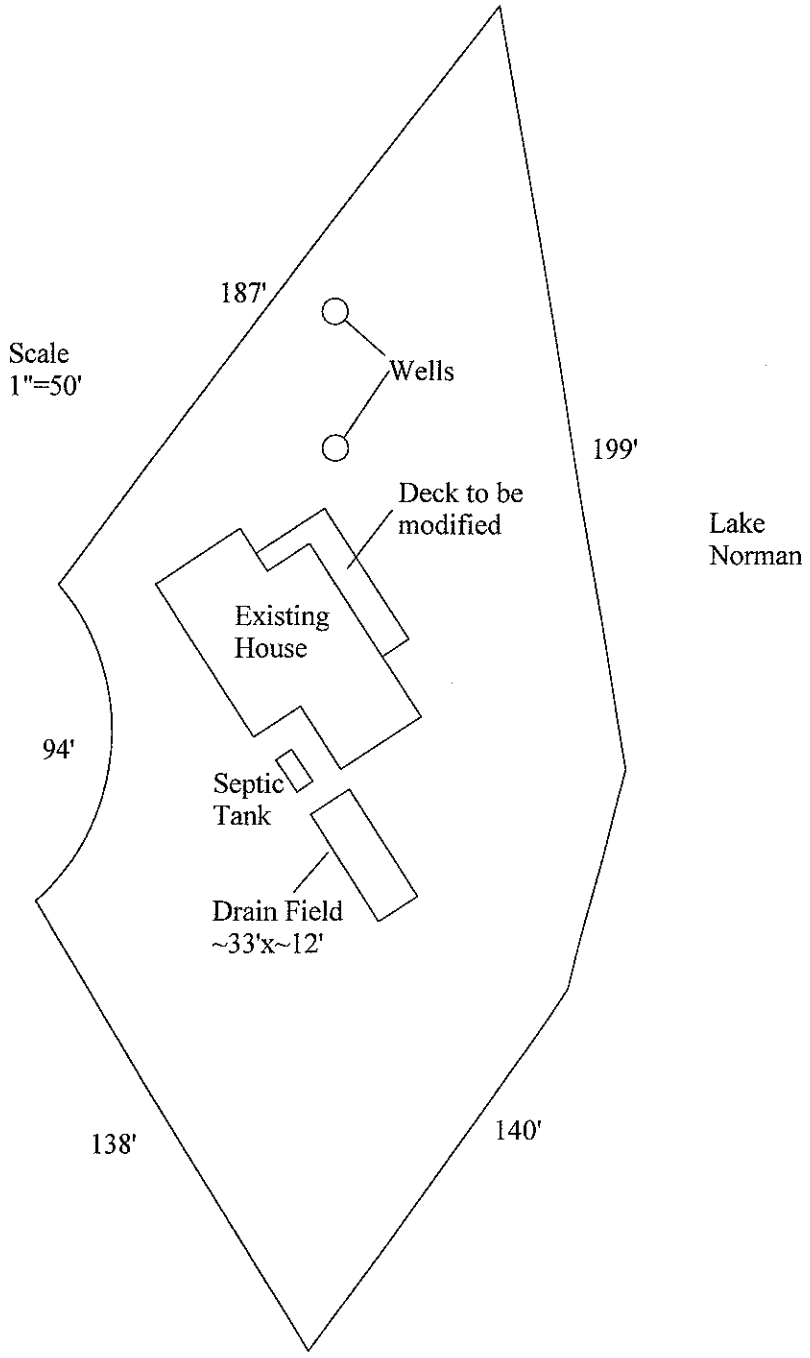

APPROVED SEP 22 2014