IREDELL COUNTY HEALTH DEPARTMENT

Statesville Office (704) 878-5305 | Mooresville Office (704) 660-3625 | PERMIT # 21231

BA

IMPROVEMENT PERMIT / AUTHORIZATION TO CONSTRUCT / OPERATION PERMIT / EXISTING SYSTEM

PIN # 4638643570

APPLICANT: Steven L Cook | APPLICANT ADDRESS: 204 Normandy Rd. Mooresville, NC 28117

SITE ADDRESS: 204 Normandy Rd | PHONE: | ALT. PHONE:

SITE DIRECTIONS: Hwy 150 W TR Perth Rd TL Normandy Rd 1/2 mile on right

SUBDIVISION: Lot 7 | SECTION: 11 | LOT # 70 | LOT AREA: | DESIGN FLOW: | L.T.A.R.:

Septic Tank	Exist (gal)	STB		Date		☐ New System	☐ Repair	☐ Expansion	System Type:	I II III IV V VI	
Pump Tank	(gal)	PT		Date		System Description:	Existing Gravel Bed				
Pump Make	Exist Model			Serial #		Repair System Description:	recorded prior to 1983				
# Nitrification Fields	# Lines			Linear Ft:		Maintenance Agreement Required:	☐ YES	☒ NO			
Trench Width	Bed 33'X 12	Max. Trench Bottom Depth		Gravel Depth			☒ GRAVITY	☐ PRESSURE			


☐ Residence ☐ Business ☒ Other ☐ Slab ☐ Basement w/plumbing
No. Bedrooms | No. Persons | No. Employees
☐ Crawl Space ☐ Basement w/o plumbing

Water Supply: ☒ Private ☑ Public ☐ Community

Comments / Conditions: Proposed house addition meets setbacks to well(s) and septic

Enlarging bedroom, Number of bedrooms is staying the same

INITIAL SITE SKETCH

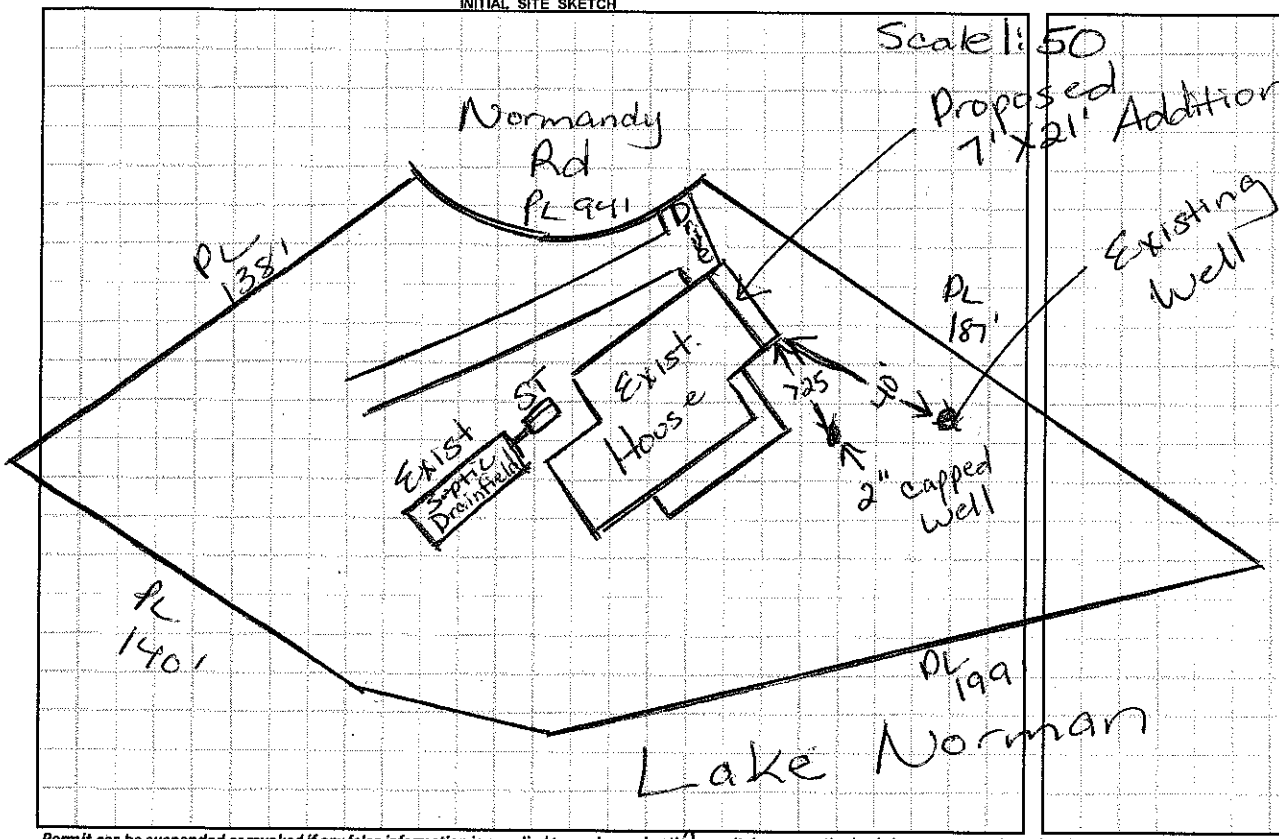

AS BUILT SKETCH

Permit can be suspended or revoked if any false information is supplied toward securing the permit / any unauthorized changes are made to the site / any unauthorized changes are made in the installation of the system. **CONTACT A LOCATOR SERVICE PRIOR TO ANY EXCAVATION**

☐ **IMPROVEMENT PERMIT** *with plat valid without expiration.* ☐ **IMPROVEMENT PERMIT** *with site plan valid for 60 mos.* ☐ **AUTHORIZATION TO CONSTRUCT** *valid for period equal to IMPROVEMENT PERMIT--not to exceed 60 mo.*

Owner / Applicant Signature: [signature] Date: | Installed by:

IMPROVEMENT PERMIT by: Date: | OPERATION PERMIT by: Date:

AUTHORIZATION TO CONSTRUCT by: Date: | Existing System Inspected by: [signature] Date: 8/26/15

Health Dept. Copy - WHITE Applicant (Final Approval) - YELLOW Applicant (Conditional Approval) - PINK