IREDELL COUNTY HEALTH DEPARTMENT

Statesville Office (704) 878-5305 | Mooresville Office (704) 660-3625 | PERMIT # 112813

IMPROVEMENT PERMIT / AUTHORIZATION TO CONSTRUCT / OPERATION PERMIT / EXISTING SYSTEM

APPLICANT: Zachary Whitson | APPLICANT ADDRESS: 182 Normandy Rd.

PIN # 4638-64-5131.000

SITE ADDRESS: 182 Normandy Rd. Mooresville NC | PHONE: 650-269-9726 | ALT. PHONE:

SITE DIRECTIONS: Perth Rd. To Normandy, Lot on R

SUBDIVISION: Cl.T | SECTION: 11 | LOT # 1087 | LOT AREA: 1.040 ACRE | DESIGN FLOW: 480 GPD | L.T.A.R.: Existing .3

Septic Tank	Existing (gal)	STB		Date			
Pump Tank	Existing (gal)	PT		Date			
Pump Make	Existing	Model		Serial #			
# Nitrification Fields	Ex.	# Lines	Existing	Linear Ft:	Ex.		
Trench Width	Ex.	Max. Trench Bottom Depth	Ex.	Gravel Depth	N/A		

☐ New System ☐ Repair ☐ Expansion System Type: I II III (IV) V VI

System Description: Relocation LP-PPBPS (Supply Line)

Repair System Description: LP-PPBPS

Maintenance Agreement Required: ☒ YES ☐ NO

☐ GRAVITY ☒ PRESSURE

☒ Residence No. Bedrooms 4 | ☐ Business | ☐ Other | ☒ Slab (Garage) ☐ Crawl Space ☐ Basement (Garage) ☒ Basement w/plumbing (Ex. House) ☐ Basement w/o plumbing


No. Persons 8 | No. Employees

Water Supply: ☒ Private ☐ Public ☐ Community

Comments / Conditions: Prior To Evaluation, Supply Line was Relocated Around Proposed Garage. 5' of Separation was Observed - Schedule 40 2" Pipe was Hooked Back Into Existing Supply Line.

New Supply Line is 8"-10" in Depth. Pressure Head To Be Set And Other Pump Tank Components Are To Be Inspected.

INITIAL SITE SKETCH

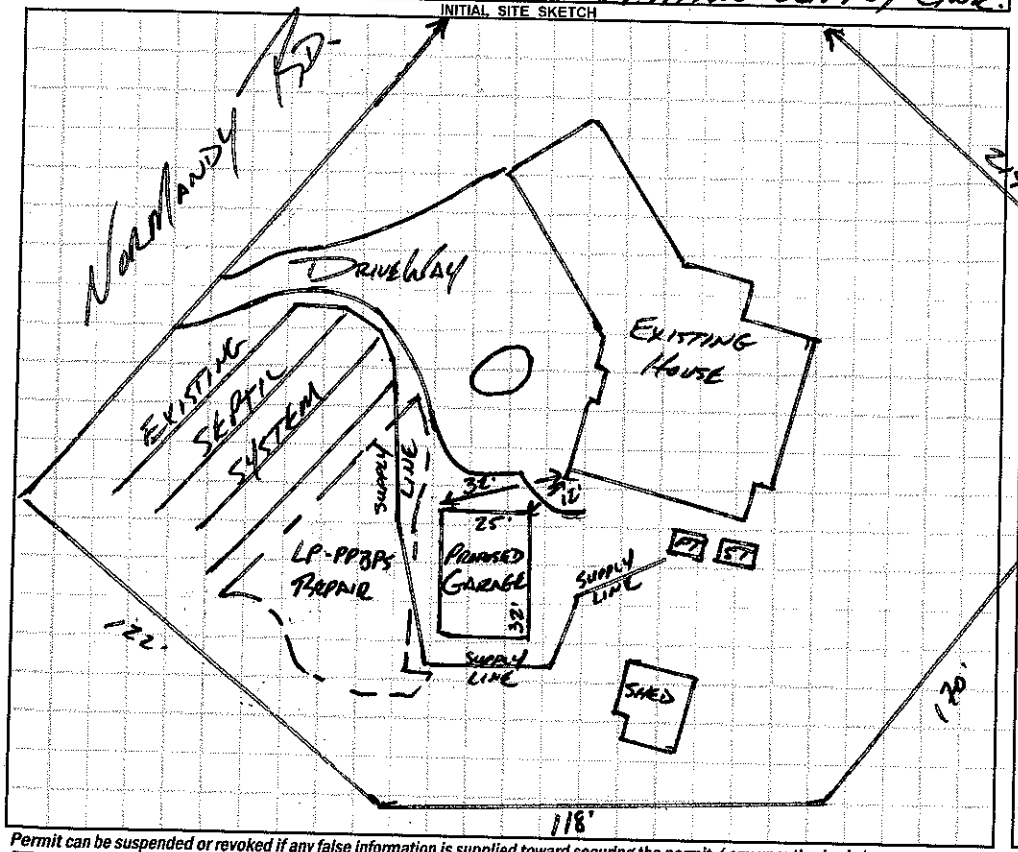

AS BUILT SKETCH

1" = 50'

10/28/15

- Checked Supply Line
- Set New Alarm Float
- System Fully Installed
- New Gate Valve on Line 4
- Sealed Electrical
- Set Head Pressure & Flushed Lines.

Permit can be suspended or revoked if any false information is supplied toward securing the permit / any unauthorized changes are made to the site / any unauthorized changes are made in the installation of the system. **CONTACT A LOCATOR SERVICE PRIOR TO ANY EXCAVATION**

☐ **IMPROVEMENT PERMIT** *with plat valid without expiration.* ☒ **IMPROVEMENT PERMIT** *with site plan valid for 60 mos.* ☒ **AUTHORIZATION TO CONSTRUCT** *valid for period equal to IMPROVEMENT PERMIT--not to exceed 60 mo.*

Owner / Applicant Signature: Zach White Date: 10/27/15 Installed by: N Ervin

IMPROVEMENT PERMIT by: APPROVED Date OCT 20 2015 OPERATION PERMIT by:

AUTHORIZATION TO CONSTRUCT by: APPROVED Date OCT 20 2015 Existing System Inspected by: APPROVED OCT 28 2015 Date:

Health Dept. Copy - WHITE Applicant (Final Approval) - YELLOW Applicant (Conditional Approval) - PINK