4638 64 5131

IREDELL COUNTY HEALTH DEPARTMENT

STATESVILLE 704-878-5305 MOORESVILLE 704-664-5281

IMPROVEMENT PERMIT / CERTIFICATE OF COMPLETION / OPERATION PERMIT / EXISTING SYSTEM INSPECTION

PROPERTY DESCRIPTION NO. 17592 DATE 6/15/95 TAX MAP NO. 2P 4A 67 Watershed: [X] Yes [ ] No

OWNER OR CONTRACTOR Beth Lattimer PHONE: Business 337-5522 Home

ADDRESS Statts Rd. - Mallard Head Condos

LOCATION Normandy Rd. past lake over hill on (R) before Outside Loop

SUBDIVISION C & T BLOCK / SECTION 11 LOT 1687 LOT AREA 1.0 ± AC SITE CLASS. PS DESIGN FLOW 480 L.T.A.R. .3

Septic Tank: 1000 Gallons; STB 794 Date 8/31/95

Pump Tank: 1000 Gallons; PT 27 Date 9/25/95

Pump Make: Model Serial No.

Nitrification Field: No Fields 1 Square Feet 1600 Linear Feet 266 (533)

No Lines 4 Trench Width 24" Max Trench Bottom Depth 32" Gravel Depth

[X] New System [ ] Repair System Type: I, II, (III), IV, V, VI

System Description: Pres Panel - Pres Manifold

Repair System Description: None

Maintenance Agreement Required: [X] Yes [ ] No

[X] House/Mod. Home No. Bedrooms 4

[ ] Mobile Home No. Bathrooms 3.5

[ ] Business No. Employees

[ ] Other

[ ] Slab [ ] Crawl Space [X] Basement w/plumbing [ ] Basement wo/plumbing


Water Supply: [X] Individual [ ] Community [ ] Public

Comments: 50 Reduction for ½ Pressure Pressure Manifold or Maintenance Contract required. - 4" Manifold capacity for 8 1/2" taps

Comments: Top 2 liners checked 11/28/95 AWS

Maintenance Contract Attached

INITIAL SITE SKETCH

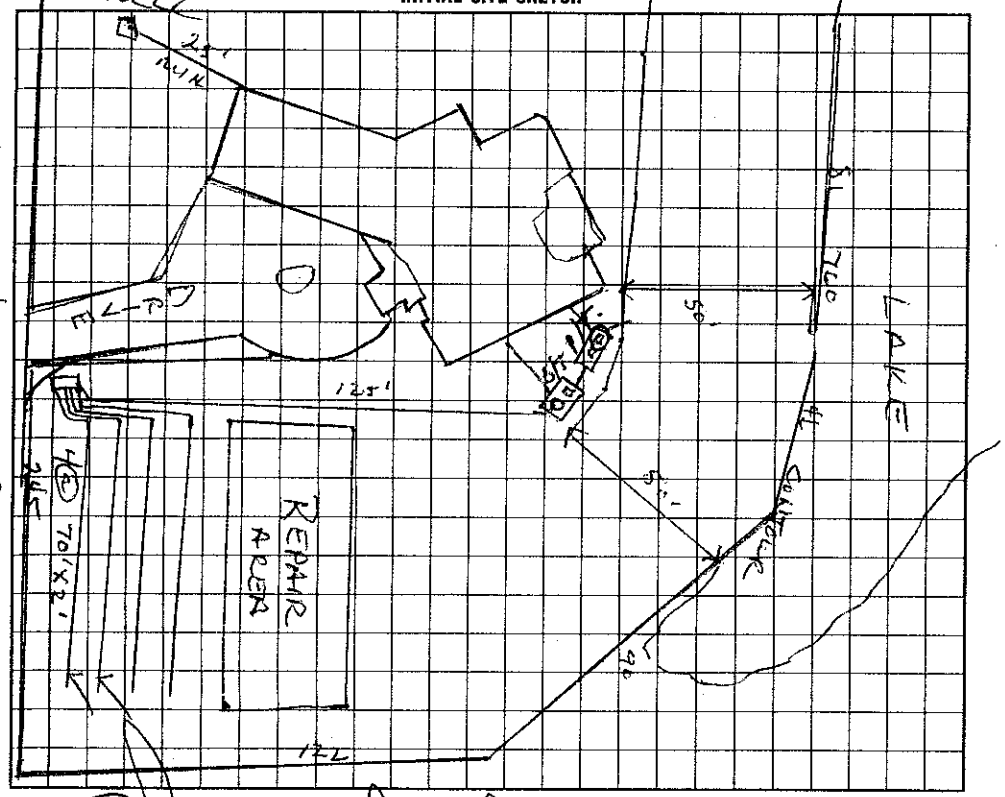

AS BUILT SKETCH

I understand that this permit can be suspended or revoked if any false information is supplied toward securing the permit/any unauthorized changes are made to the site/any unauthorized changes are made in the installation of the system. Improvement Permit is valid for 60 months from date of issuance.

Signed: Beth M. Lattimer

Improvement Permit by: Wesley Sparks R.S. date 6/15/95

Existing System Inspection by: date

Installed by: F I Erwin

Certificate of Completion by: Wesley Sparks L.S. date 12/19/95

Operation Permit by: Wesley Sparks R.S. date 12/19/95

HEALTH DEPT. COPY: WHITE INSPECTION COPY (FINAL): GREEN OWNER COPY (FINAL): YELLOW INSPECTION COPY (INITIAL): PINK OWNER COPY (INITIAL): GOLD