878-3127

IREDELL COUNTY HEALTH DEPARTMENT

Authorization to construct

STATESVILLE 704-878-5305 MOORESVILLE 704-664-5281

IMPROVEMENT PERMIT / ~~CERTIFICATE OF COMPLETION~~ / OPERATION PERMIT / EXISTING SYSTEM INSPECTI

PROPERTY DESCRIPTION NO. 25718 DATE 1/25/97 TAX MAP NO. 25 3 A 42 4638659819 Watershed: ~~Yes~~ No

OWNER OR CONTRACTOR KENNETH AUSTIN PHONE: Business Home 664-9236

ADDRESS 215 HIDE AWAY LANE

LOCATION 150 W. OF RT 115 FROM TL HIDEAWAY - ~~R~~ 215 HIDEAWAY - ON LEFT

SUBDIVISION CLT BLOCK / SECTION 14 LOT 42 LOT AREA .196Ac SITE CLASS. PS DESIGN FLOW 360 L.T.A.R. -

Septic Tank: 1000 EXISTING Gallons; STB EXISTING Date

Pump Tank: 1000 Gallons; PT 1087 Date 4/23/97

Pump Make: LANCASTER Model SP250 Serial No. -

Nitrification Field: No Fields 1 Square Feet 450 Linear Feet 150

No Lines 2@50' Trench Width 36" Max Trench Bottom Depth 24" ~~Gravel Depth~~ SAND

☑ New System ☐ Repair System Type: I, II, (III), IV, V, VI

System Description: PUMP CHAMBERED

Repair System Description: PANEL

Maintenance Agreement Required: ☐ Yes ☑ No

☑ House/Mod. Home No. Bedrooms 3

☐ Mobile Home No. Bathrooms 2

☐ Business No. Employees

☐ Other


☐ Slab ☑ Crawl Space ☐ Basement w/plumbing ☐ Basement wo/plumbing

Water Supply: ☑ Individual ☐ Community ☐ Public


Comments:

Comments: LINES, TANK checked 6/18/97

INITIAL SITE SKETCH

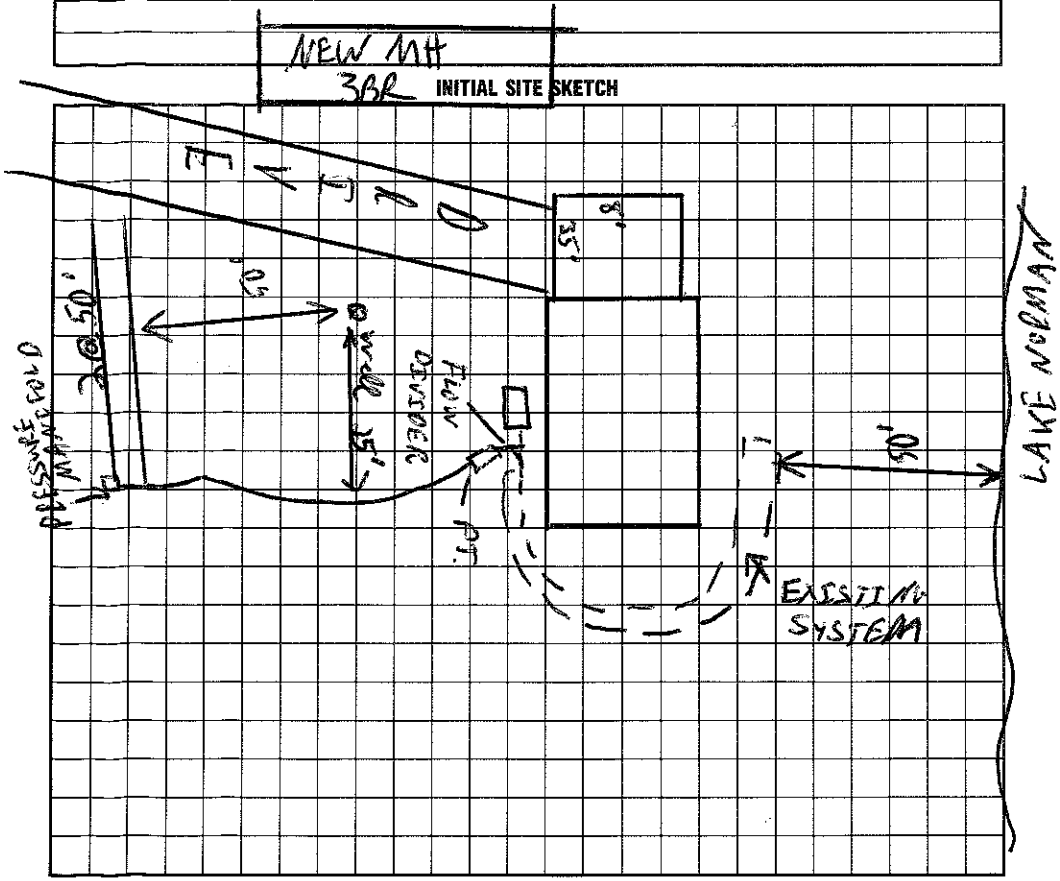

AS BUILT SKETCH

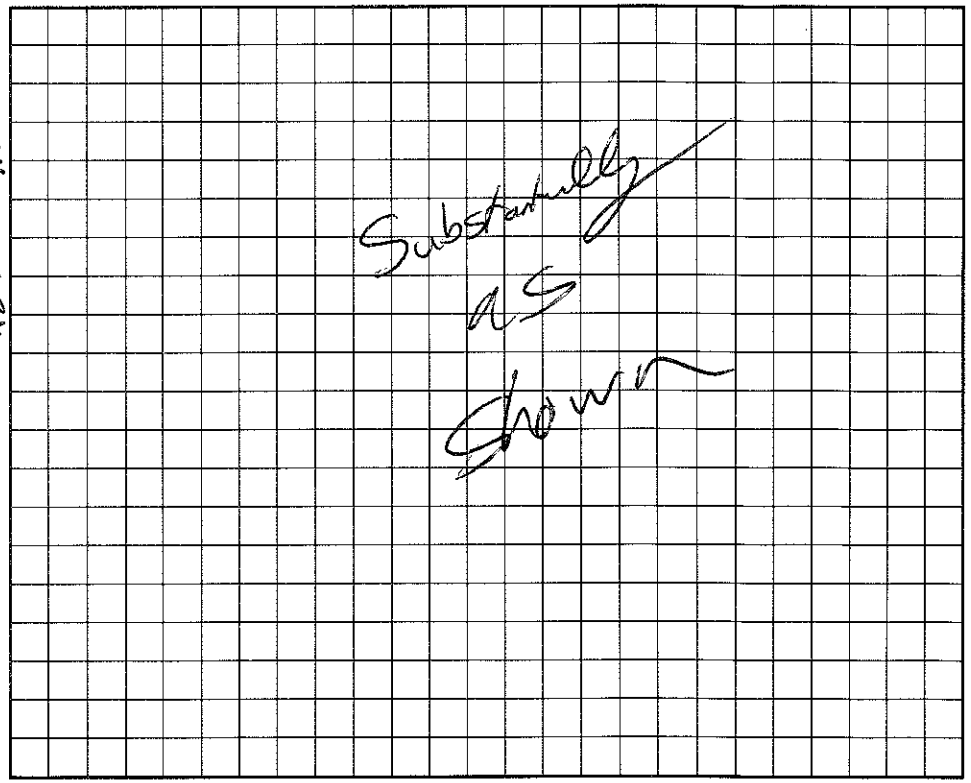

I understand that this permit can be suspended or revoked if any false information is supplied toward securing the permit/any unauthorized changes are made to the site/any unauthorized changes are made in the installation of the system. Improvement Permit is valid for 60 months from date of issuance.

Signed: Margaret H. Austin

Installed by: WAYNE CLONTZ

Improvement Permit by: C. Blythe EHS date 1/25/97

Certificate of Completion by: date

~~Existing System Inspection by:~~ C. Blythe EHS date 1/25/97

Operation Permit by: C. Blythe date 6/26/97

Authorization to construct

HEALTH DEPT. COPY: WHITE ~~INSPECTION~~ COPY (FINAL): GREEN OWNER COPY (FINAL): YELLOW ~~INSPECTION COPY (INITIAL): PINK~~ OWNER COPY (INITIAL): GOLD