(300)

IREDELL COUNTY HEALTH DEPARTMENT Const. Auth. STATESVILLE 704-878-5305 MOORESVILLE 704-664-5281

IMPROVEMENT PERMIT / ~~CERTIFICATE OF COMPLETION~~ / OPERATION PERMIT / EXISTING SYSTEM INSPECTION

PROPERTY DESCRIPTION NO. 23992 DATE Nov. 5, '96 TAX MAP NO. Part of 2SA80 Watershed: ☑ Yes ☐ No

OWNER OR CONTRACTOR Stumpy Creek LLC PHONE: Business 633-6124 ~~Home~~ 4638-66-0827

ADDRESS 614 N. Main Salisbury NC 28144

LOCATION Perth Rd. W. TL Stumpy Creek Rd. TL Collingswood 17 th on left

SUBDIVISION Harborview BLOCK / SECTION III LOT 31 LOT AREA .63 SITE CLASS. PSpec. 1996 DESIGN FLOW 440gpd L.T.A.R. ~.23

Septic Tank: 1000 Gallons; STB 825 Date 2/10/97

Pump Tank: _____ Gallons; PT _____ Date _____

Pump Make: _____ Model _____ Serial No. _____

Nitrification Field: No Fields 1 Square Feet 1200 Linear Feet 400

No Lines 5 Trench Width 36" Max Trench Bottom Depth ~24" Gravel Depth NA

☑ New System ☐ Repair System Type: I, II, III, IV, V, VI

System Description: gravity chamber

Repair System Description: same

Maintenance Agreement Required: ☐ Yes ☑ No

☑ House/Mod. Home ☐ Mobile Home ☐ Business ☐ Other

No. Bedrooms 4 No. Bathrooms 2½ No. Employees ____

☑ Slab ☐ Crawl Space ☐ Basement w/plumbing ☐ Basement wo/plumbing


Water Supply: ☐ Individual ☑ Community ☐ Public

Comments:

Comments:

1" = 50'

INITIAL SITE SKETCH

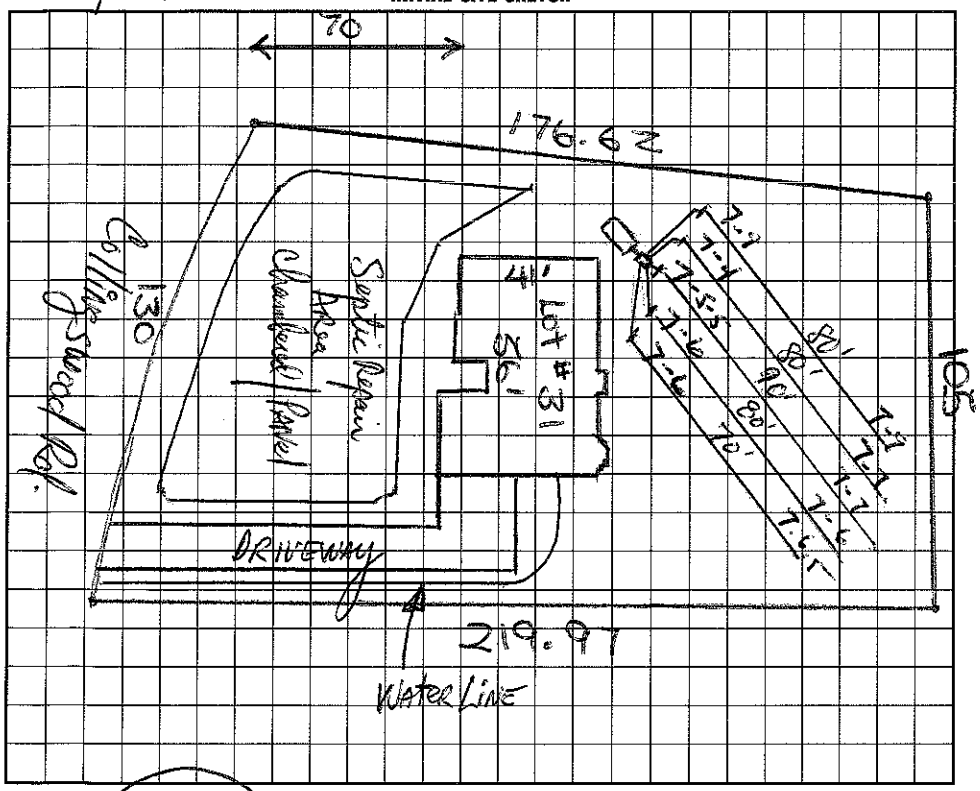

AS BUILT SKETCH

I understand that this permit can be suspended or revoked if any false information is supplied toward securing the permit/any unauthorized changes are made to the site/any unauthorized changes are made in the installation of the system.

Signed: _____

Improvement Permit by: Mark R. Henson, RS. date 11-5-96

~~Existing System~~ Construction Authorization Inspection by: D. Henson, RS date 4-4-97

Installed by: Rowan Septic Tank

Certificate of Completion by: Wesley Sparks RS. date 4/25/97

Operation Permit by: Wesley Sparks RS. date 4/25/97

HEALTH DEPT. COPY: WHITE INSPECTION COPY (FINAL): GREEN OWNER COPY (FINAL): YELLOW INSPECTION COPY (INITIAL): PINK OWNER COPY (INITIAL): GOLD