2 3a

IREDELL COUNTY HEALTH DEPARTMENT Coast. Auth.

STATESVILLE 704-878-5305 MOORESVILLE 704-664-5281

IMPROVEMENT PERMIT / ~~CERTIFICATE OF COMPLETION~~ / OPERATION PERMIT / EXISTING SYSTEM INSPECTION

PROPERTY DESCRIPTION NO. 23993 DATE April 28, 1997 TAX MAP NO. part of 25A80 Watershed: ☒ Yes ☐ No

OWNER OR CONTRACTOR Mike Turpin PHONE: Business Home (704) 663-0624

ADDRESS 22028 Mayhew Rd Mooresville, NC 28115 4638-66-0939

LOCATION Perth Rd. N TL Stumpy Creek TL Collingwood Rd on left near end

SUBDIVISION Harborview BLOCK / SECTION III LOT 32 LOT AREA .60 Acre SITE CLASS. P.S. DESIGN FLOW 360 gpd L.T.A.R. N.3

Septic Tank: 1000 Gallons; STB 794 Date 8/13/97

Pump Tank: _____ Gallons; PT _____ Date _____

Pump Make: _____ Model _____ Serial No. _____

Nitrification Field: No Fields 1 Square Feet 1200 Linear Feet 400'

No Lines 5 at 80' Trench Width 36" Max Trench Bottom Depth 24" Gravel Depth 12"

☒ New System ☐ Repair System Type: I, (II) III, IV, V, VI

System Description: Gravity Conventional

Repair System Description: Gravity Chambered

Maintenance Agreement Required: ☐ Yes ☐ No

☒ House/Mod. Home ☐ Mobile Home ☐ Business ☐ Other

No. Bedrooms 3 No. Bathrooms 2 No. Employees ____

☒ Slab ☐ Crawl Space ☐ Basement w/plumbing ☐ Basement wo/plumbing

Water Supply: ☐ Individual ☒ Community ☐ Public


Comments:

Scale 1"=50'

Comments:

Installed as shown on Auth Const.

INITIAL SITE SKETCH

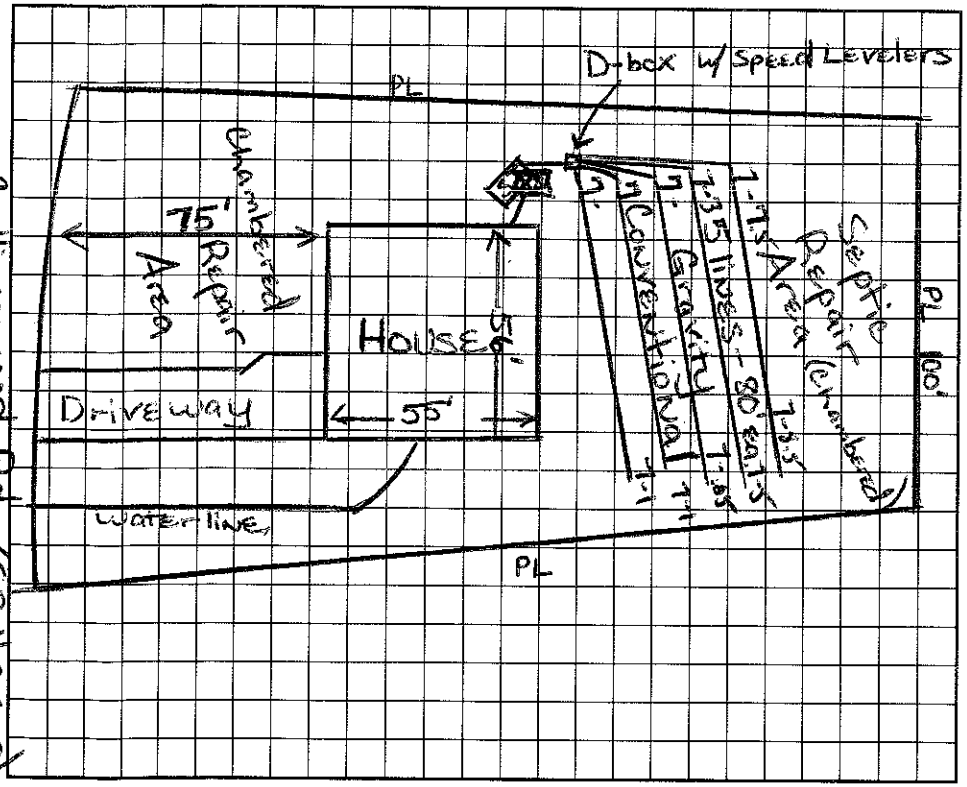

AS BUILT SKETCH

I understand that this permit can be suspended or revoked if any false information is supplied toward securing the permit/any unauthorized changes are made to the site/any unauthorized changes are made in the installation of the system. Improvement Permit is valid for 60 months from date of issuance.

Signed: Michael D. Turpin

Improvement Permit by: Maria Dotson date 4/28/97

Existing System Inspection by: Maria Dotson date 4/28/97

Installed by: Dave Clark

Certificate of Completion by: Wesley Sparks R.S. date 10/29/97

Operation Permit by: Wesley Sparks R.S. date 10/29/97

Coastal Auth.

APPLICANT COPY: WHITE INSPECTION COPY (FINAL): GREEN OWNER COPY (FINAL): YELLOW INSPECTION COPY (INITIAL): PINK OWNER COPY (INITIAL): GOLD