IREDELL COUNTY HEALTH DEPARTMENT

STATESVILLE 704-878-5305 280.00 Paid MOORESVILLE 704-664-5281

IMPROVEMENT PERMIT / AUTHORIZATION TO CONSTRUCT / OPERATION PERMIT / EXISTING SYSTEM INSPECTION

PERMIT# 110770 PIN# 4638 66 1683 DATE 1/14/03

OWNER OR CONTRACTOR JERRY CHERRY PHONE: Business Home 704-528-4681

ADDRESS 230 COLLINGSWOOD RD, MOORESVILLE, NC. 28115

LOCATION PERTH N TL STUMPY CREEK TL COLLINGSWOOD TO 5th lot on (R) B4 Cul de sac

SUBDIVISION CL+T BLOCK / SECTION 14 LOT 64 LOT AREA .73AC SITE CLASS. PS DESIGN FLOW 360 L.T.A.R. .3

Septic Tank: 1000 Gallons; STB 1007 Date 12/30/02
Pump Tank: Gallons; PT Date
Pump Make: Model Serial No.
Nitrification Field: No Fields 1 Square Feet 900 Linear Feet 300
No Lines 4@75' Trench Width 3' Max Trench Bottom Depth 3' Gravel Depth NA

[X] New System [ ] Repair System Type: I, II, (III), IV, V, VI
System Description: GRAVITY - 25% Reduced
Repair System Description: 50% Reduced
Maintenance Agreement Required: [ ] Yes [X] No

[X] House/Mod. Home No. Bedrooms 3
[ ] Mobile Home No. Bathrooms 2
[ ] Business No. Employees
[ ] Other
[ ] Slab [X] Crawl Space [ ] Basement w/plumbing [ ] Basement wo/plumbing


Water Supply: [X] Individual [ ] Public [ ] Community
EXISTING

Comments:/Conditions:

Comments:/Conditions:

1" = 50'

INITIAL SITE SKETCH

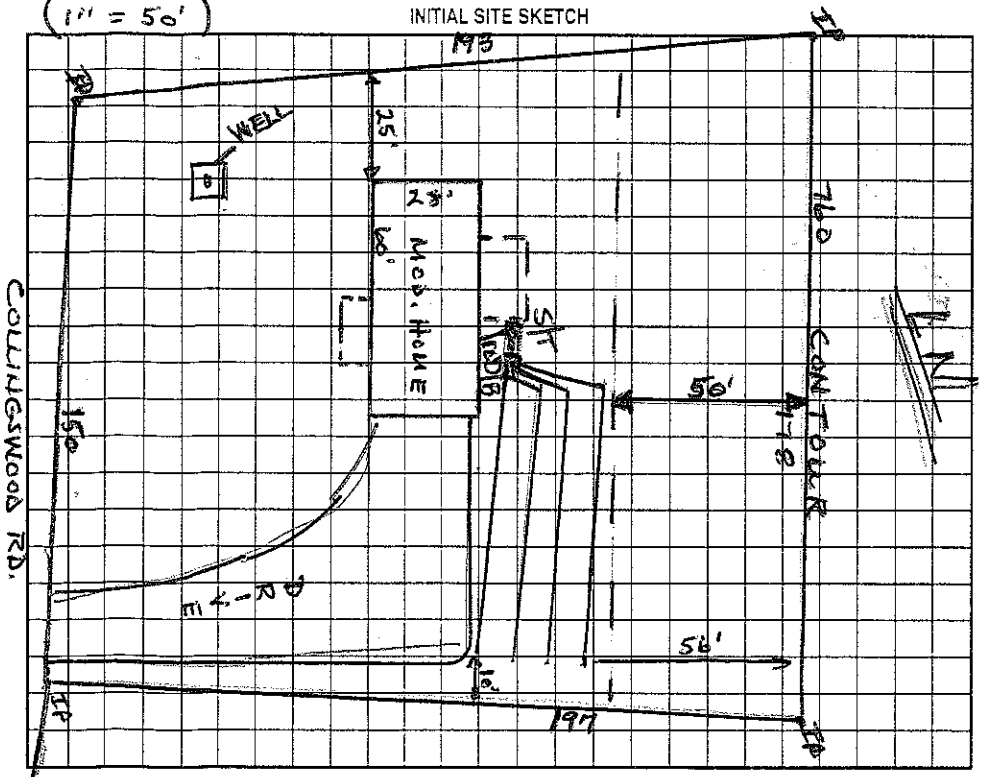

AS BUILT SKETCH

Permit can be suspended or revoked if any false information is supplied toward securing the permit/any unauthorized changes are made to the site/any unauthorized changes are made in the installation of the system. Improvement Permit with plat valid without expiration. Improvement Permit with site plan valid for sixty months. Authorization to Construct is valid for a period equal to that of Improvement Permit – not to exceed sixty months.

Signed: * Jerry Lynn Cherry date 2/5/03 Installed by: Wayne Clontz

Improvement Permit by: Wesley Sparks RS. date 1/14/03 Operation Permit by: Wesley Sparks R.S. date 3/28/03

Authorization to Construct by: Wesley Sparks RS. date 1/14/03 Existing System Inspection by: date

HEALTH DEPT. COPY: WHITE OWNER COPY (FINAL): YELLOW OWNER COPY (INITIAL): PINK