IREDELL COUNTY HEALTH DEPARTMENT

Statesville Office (704) 878-5305 SC Mooresville Office (704) 660-3625 PERMIT # 211228

IMPROVEMENT PERMIT / AUTHORIZATION TO CONSTRUCT / OPERATION PERMIT / EXISTING SYSTEM

PIN # 4638-66-2758

APPLICANT: ROBERT ARCHAMBEAU APPLICANT ADDRESS: 326 NORMANDY RD

SITE ADDRESS: 236 COLLINGSWOOD RD PHONE: 704-360-4291 ALT. PHONE:

SITE DIRECTIONS: PERTH, TL STUMPY CREEK, TL COLLINGSWOOD, ON R

SUBDIVISION: CLET SECTION: 14 LOT # 63 LOT AREA: .64AC DESIGN FLOW: 360 L.T.A.R.:

Septic Tank	1000 (gal)	STB	INFILTRATOR	Date			
Pump Tank	(gal)	PT		Date			
Pump Make		Model		Serial #			
# Nitrification Fields	# Lines			Linear Ft:			
Trench Width		Max. Trench Bottom Depth		Gravel Depth	—		

☐ New System ☒ Repair ☐ Expansion System Type: I II III IV V VI

System Description:

Repair System Description: TANK

Maintenance Agreement Required: ☐ YES ☒ NO

☒ GRAVITY ☐ PRESSURE

☒ Residence No. Bedrooms 3

☐ Business No. Persons

☐ Other No. Employees


☐ Slab ☐ Crawl Space

☐ Basement w/plumbing ☐ Basement w/o plumbing

Water Supply: ☒ Private ☐ Public ☐ Community

Comments / Conditions:

INITIAL SITE SKETCH

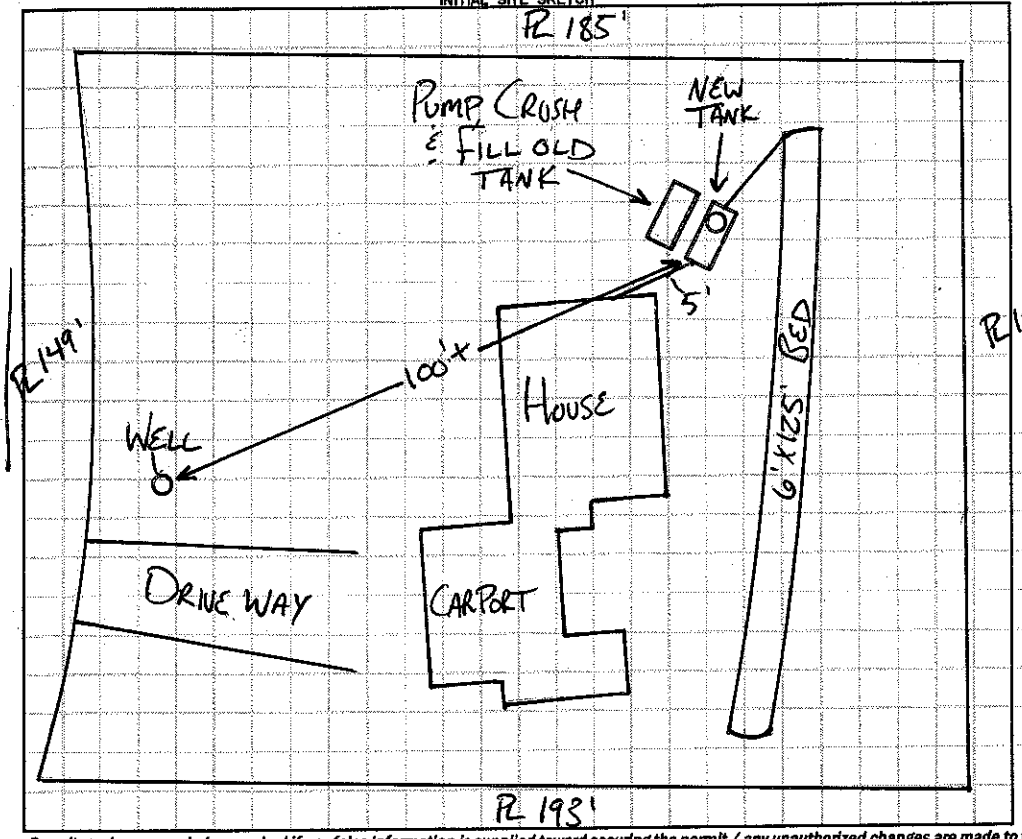

AS BUILT SKETCH

1"=40'

INSTALLED AS SHOWN

LAKE

Permit can be suspended or revoked if any false information is supplied toward securing the permit / any unauthorized changes are made to the site / any unauthorized changes are made in the installation of the system. **CONTACT A LOCATOR SERVICE PRIOR TO ANY EXCAVATION**

☐ **IMPROVEMENT PERMIT** *with plat valid without expiration.* ☐ **IMPROVEMENT PERMIT** *with site plan valid for 60 mos.* ☒ **AUTHORIZATION TO CONSTRUCT** *valid for period equal to IMPROVEMENT PERMIT--not to exceed 60 mo.*

Owner / Applicant Signature: Date: 6/22/15 Installed by:

IMPROVEMENT PERMIT by: APPROVED JUN 16 2015 Date: OPERATION PERMIT by: LENTZ Date: 7-7-15

AUTHORIZATION TO CONSTRUCT by: APPROVED JUN 16 2015 Date: Existing System Inspected by: Date:

Health Dept. Copy - WHITE Applicant (Final Approval) - YELLOW Applicant (Conditional Approval) - PINK