50.00 Pd.

IREDELL COUNTY HEALTH DEPARTMENT

STATESVILLE 704-878-5305 MOORESVILLE 704-664-5281

IMPROVEMENT PERMIT / AUTHORIZATION TO CONSTRUCT / OPERATION PERMIT / EXISTING SYSTEM INSPECTION

PERMIT# 120210 PIN# 4638667686 DATE 3-16-06

OWNER OR APPLICANT Dennis Isenhour PHONE: Business _____ Home 872-6202

ADDRESS 146 Isenhour Farm Rd Cleveland NC 27013

LOCATION #257 Hideaway Ln. Hwy 150 West TR Peth Rd TL Hideaway Ln go to very end Cul-de-sac

SUBDIVISION C & T BLOCK / SECTION 14 LOT 50 LOT AREA 1.06 Acres SITE CLASS. PS DESIGN FLOW 360 gpd L.T.A.R. _____

Septic Tank: Existing Gallons; STB _____ Date _____
Pump Tank: _____ Gallons; PT _____ Date _____
Pump Make: _____ Model _____ Serial No. _____
Nitrification Field: No Fields ___ Square Feet Existing Linear Feet _____
No Lines _____ Trench Width Existing Max Trench Bottom Depth _____

☐ New System ☐ Repair ☐ Expansion System Type: I II III IV V VI
System Description: Existing Gravity Conventional
Repair System Description: Same/Innovative
Maintenance Agreement Required: ☐ Yes ☒ No

☒ House/Mod. Home No. Bedrooms 3
☐ Mobile Home No. Persons ___
☐ Business No. Employees ___
☐ Other _____


Water Supply: ☐ Individual ☒ Public ☒ Community

Gravel Depth N/A ☒ Gravity ☑ Pressure ☐ Slab ☒ Crawl Space ☐ Basement w/plumbing ☐ Basement wo/plumbing


Comments/Conditions: Note: Old well to be "properly abandoned" per DHNER specs

Comments/Conditions: Existing Septic System appears to be Functioning Okay at time of inspection. Previously permitted for 3 Bedroom

INITIAL SITE SKETCH

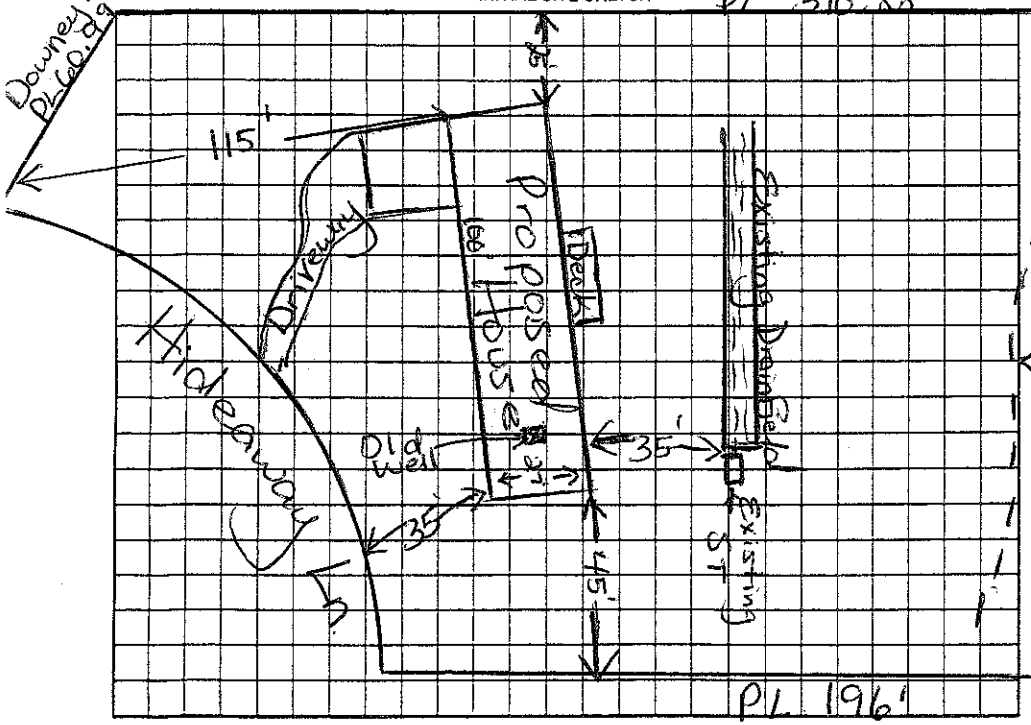

AS BUILT SKETCH

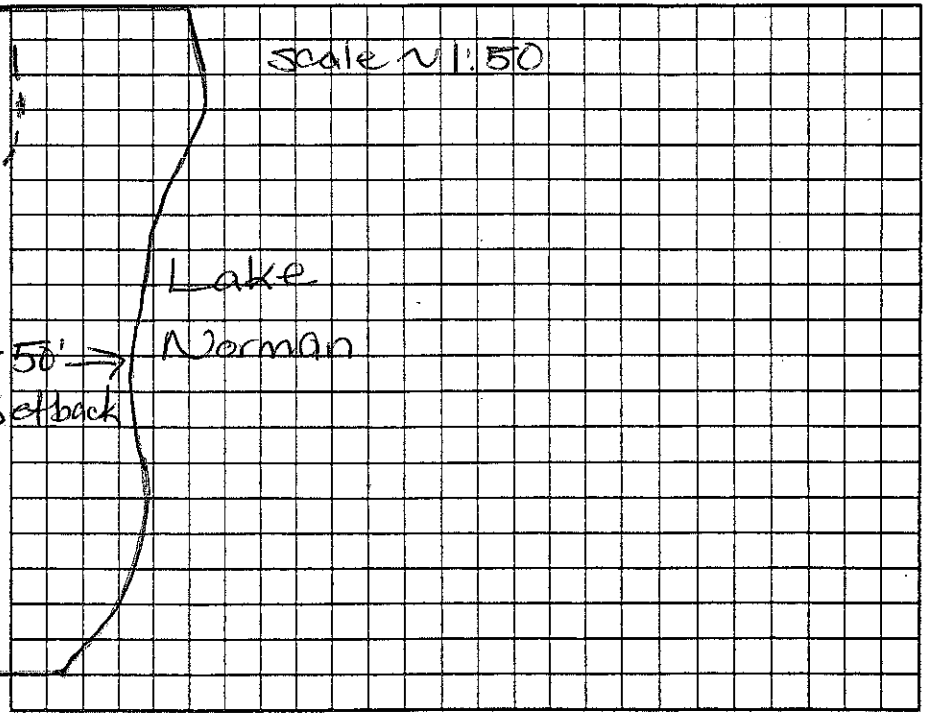

Permit can be suspended or revoked if any false information is supplied toward securing the permit/any unauthorized changes are made to the site/any unauthorized changes are made in the installation of the system. Improvement Permit with plat valid without expiration ☐ Improvement Permit with site plan valid for sixty months ☐ Authorization to Construct is valid for a period equal to that of Improvement Permit – not to exceed sixty months.

Signed Patricia C Isenhour date 3/17/06 Installed by: _____

Improvement Permit by: Maria H Dobson RS date 3/16/06 Operation Permit by: _____ date _____

Authorization to Construct by: Maria H Dobson RS date 3/16/06 Existing System Inspection by: Maria H Dobson RS date 7/30/07

HEALTH DEPT. COPY: WHITE OWNER COPY (FINAL): YELLOW OWNER COPY (INITIAL): PINK

IREDELL COUNTY HEALTH DEPARTMENT

STATESVILLE 704-878-5305 MOORESVILLE 704-664-5281

IMPROVEMENT PERMIT / AUTHORIZATION TO CONSTRUCT / OPERATION PERMIT / EXISTING SYSTEM INSPECTION

PERMIT# 077157 PIN# 4638 66 7686 DATE 10/27/98

OWNER OR CONTRACTOR Dennis Eisenhower PHONE: Business 872-6202 Home

ADDRESS 146 Eisenhower Farm Lane Cleveland, NC. 27013

LOCATION Perth N, TL Hideaway, on (L) before last drive at culdesac #257

SUBDIVISION CL+T BLOCK / SECTION 14 LOT 58 LOT AREA 1.06 SITE CLASS. PS DESIGN FLOW 360 L.T.A.R. —

Septic Tank: EXISTING Gallons; STB Date

Pump Tank: Gallons; PT Date

Pump Make: Model Serial No.

Nitrification Field: No Fields Square Feet EXISTING ~~Lineal Feet~~

No Lines Trench Width Max Trench Bottom Depth Gravel Depth

☐ New System ☐ Repair System Type: I, (II), III, IV, V, VI

System Description: ENSTING BED SYSTEM

Repair System Description:

Maintenance Agreement Required: ☐ Yes ☒ No

☐ House/Mod. Home ☒ Mobile Home ☐ Business ☐ Other LN

No. Bedrooms 3 No. Bathrooms 2.5 No. Employees

☐ Slab ☐ Crawl Space ☐ Basement w/plumbing ☐ Basement wo/plumbing


Water Supply: ☒ Individual ☐ Public ☐ Community

Comments:/Conditions:

Comments:/Conditions:

INITIAL SITE SKETCH

AS BUILT SKETCH

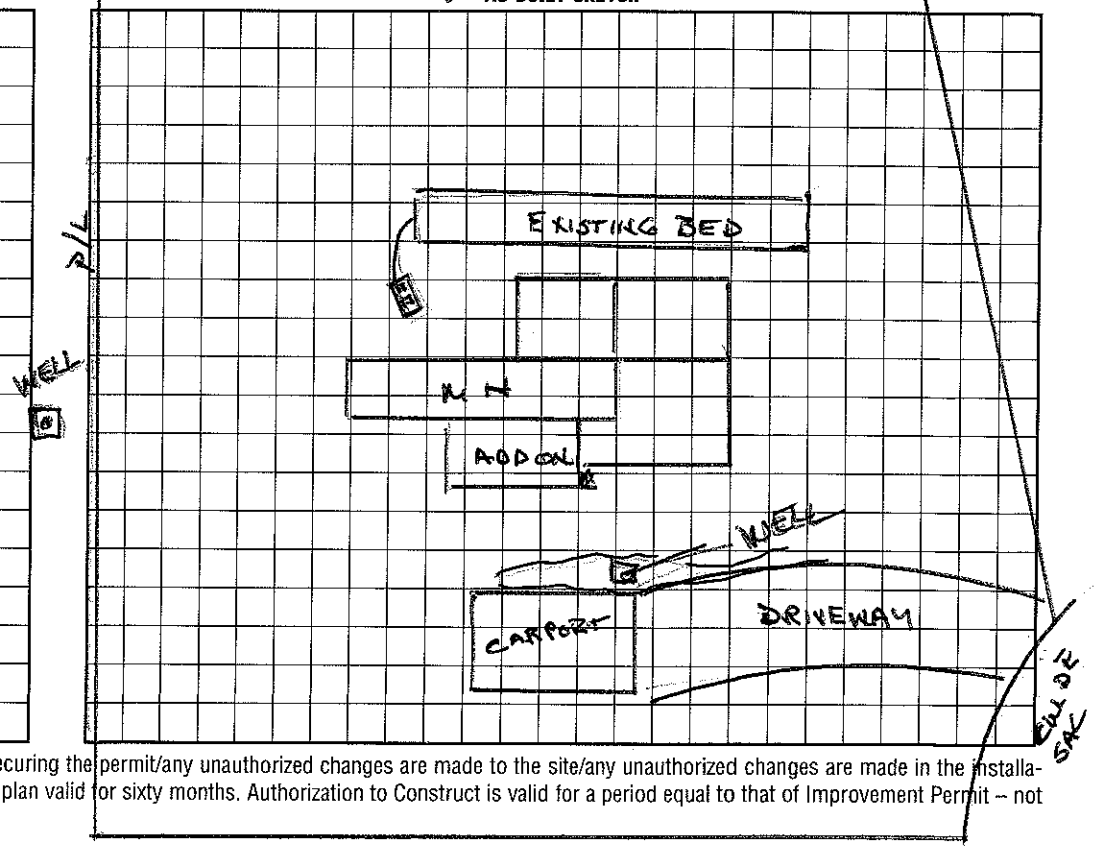

I understand that this permit can be suspended or revoked if any false information is supplied toward securing the permit/any unauthorized changes are made to the site/any unauthorized changes are made in the installation of the system. Improvement Permit with plat valid without expiration. Improvement Permit with site plan valid for sixty months. Authorization to Construct is valid for a period equal to that of Improvement Permit – not to exceed sixty months.

Signed: date

Improvement Permit by: date

Authorization to Construct by: date

Installed by:

Operation Permit by: date

Existing System Inspection by: Wesley Sparks RS. date 10/27/98

HEALTH DEPT. COPY: WHITE INSPECTION COPY (FINAL): GREEN OWNER COPY (FINAL): YELLOW INSPECTION COPY (INITIAL): PINK OWNER COPY (INITIAL): GOLD