IREDELL COUNTY HEALTH DEPARTMENT

STATESVILLE 704-878-5305 MOORESVILLE 704-664-5281

IMPROVEMENT PERMIT / AUTHORIZATION TO CONSTRUCT / OPERATION PERMIT / EXISTING SYSTEM INSPECTION

PERMIT# 110261 PIN# 4638670140 Rick Otto DATE 12-13-02

OWNER OR CONTRACTOR Bernhardt Corporation PHONE: Business (704) 506-8610 Home 506-8640

ADDRESS 2516 D-River Hwy Mooresville, NC 28117

LOCATION Hwy 150 W TR Perth Rd TL Stumpy Creek TL Collingswood last on left

SUBDIVISION Harborview BLOCK / SECTION III LOT 33 LOT AREA .68 acre SITE CLASS. PS DESIGN FLOW 480 gpd L.T.A.R. ~.3

Septic Tank: 1000 Gallons; STB 1007 Date 4-3-03
Pump Tank: ____ Gallons; PT ____ Date ____
Pump Make: ____ Model ____ Serial No. ____
Nitrification Field: No. Fields 1 Square Feet 1200 Linear Feet 400
No Lines 5@80' Trench Width 36" Max Trench Bottom Depth ~24" Gravel Depth N/A

[X] New System [ ] Repair System Type: I, II, III, IV, V, VI
System Description: Gravity - 25% Reduction
Repair System Description: Gravity - Innovative
Maintenance Agreement Required: [ ] Yes [X] No


[X] House/Mod. Home [ ] Mobile Home [ ] Business [ ] Other
No. Bedrooms 4 No. Bathrooms 2 No. Employees ____
[ ] Slab [X] Crawl Space [ ] Basement w/plumbing [ ] Basement wo/plumbing

Water Supply: [ ] Individual [X] Public [X] Community


Comments/Conditions: Keep Septic System at least 10' from PL

Comments/Conditions: Note: Do Not grade area of house to make pad. Pad will have to be "build up" Otherwise pump may be required or "Crawlspace" needed

Scale 1"=50' INITIAL SITE SKETCH

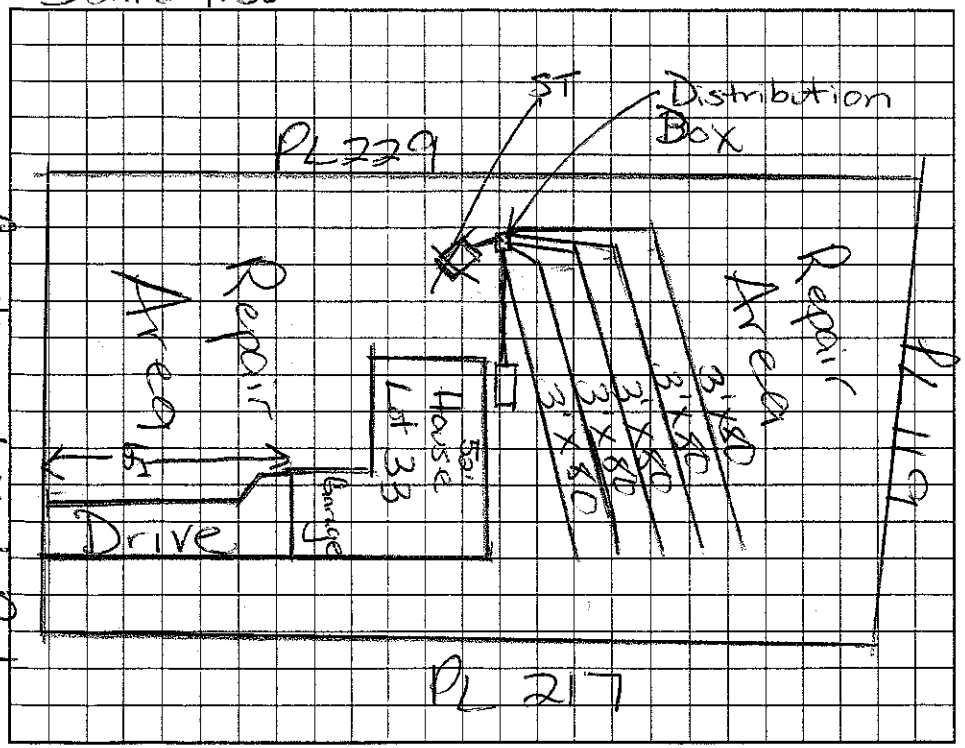

AS BUILT SKETCH Built "crawlspace"

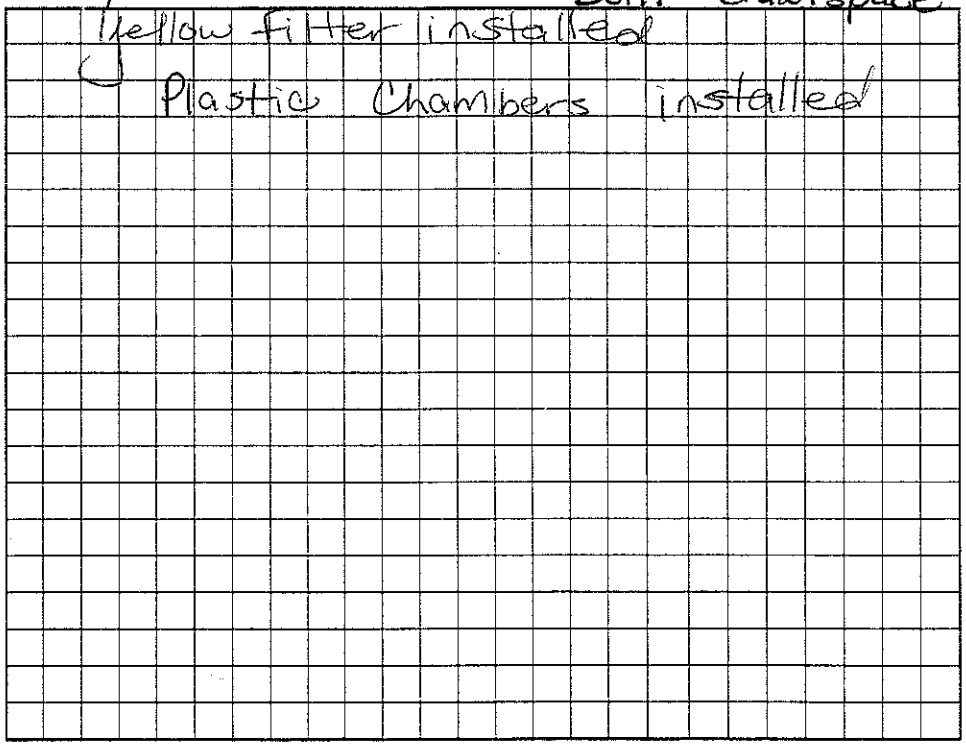

Permit can be suspended or revoked if any false information is supplied toward securing the permit/any unauthorized changes are made to the site/any unauthorized changes are made in the installation of the system. Improvement Permit with plat valid without expiration. Improvement Permit with site plan valid for sixty months. Authorization to Construct is valid for a period equal to that of Improvement Permit – not to exceed sixty months.

Signed: ____ date 1-3-3 Installed by: Wayne Clontz

Improvement Permit by: Maria H. Dotson date 12/16/02 Operation Permit by: Maria H. Dotson RS date 6/6/03

Authorization to Construct by: Maria H. Dotson date 12/16/02 Existing System Inspection by: ____ date ____

HEALTH DEPT. COPY: WHITE OWNER COPY (FINAL): YELLOW OWNER COPY (INITIAL): PINK