IREDELL COUNTY HEALTH DEPARTMENT Const. Auth

STATESVILLE 704-878-5305 MOORESVILLE 704-664-5281

IMPROVEMENT PERMIT / ~~CERTIFICATE OF COMPLETION~~ / OPERATION PERMIT / EXISTING SYSTEM INSPECTION

PROPERTY DESCRIPTION NO. 23995 DATE Nov. 5, '96 TAX MAP NO. part of 25A80

OWNER OR CONTRACTOR Stumpy Creek LLC Watershed: ☑ Yes ☐ No

ADDRESS 614 N Main St Salisbury NC 28144 PHONE: Business 633-6124 ~~Home~~ 4638-67-0222

LOCATION Faith Rd. N. TL Stumpy Creek TL Collingswood at end on left

SUBDIVISION Harborview BLOCK / SECTION III LOT 34 LOT AREA .58 Ac SITE CLASS. PS per .1956 DESIGN FLOW 480 gpd L.T.A.R. ~.3

Septic Tank: 1000 Gallons; STB 825 Date 5/2/97

Pump Tank: ______ Gallons; PT ______ Date ______

Pump Make: ______ Model ______ Serial No. ______

Nitrification Field: No Fields 1 Square Feet 1200 Linear Feet 400

No Lines 4 @ 100' Trench Width 36" Max Trench Bottom Depth ~24" Gravel Depth NA

☑ New System ☐ Repair System Type: I, II, (III), IV, V, VI

System Description: gravity chambered

Repair System Description: Same

Maintenance Agreement Required: ☐ Yes ☑ No

☑ House/Mod. Home No. Bedrooms ~~4~~ 3

☐ Mobile Home No. Bathrooms 2½

☐ Business No. Employees ______

☐ Other ______


☑ Slab ☐ Crawl Space ☐ Basement w/plumbing ☐ Basement wo/plumbing

Water Supply: ☐ Individual ☑ Community ☐ Public


Comments: 3 @ 85' x 3'
1 @ 137' x 3'

Comments: House only 3 Bedroom -
400' Conventional Drainfield installed

INITIAL SITE SKETCH

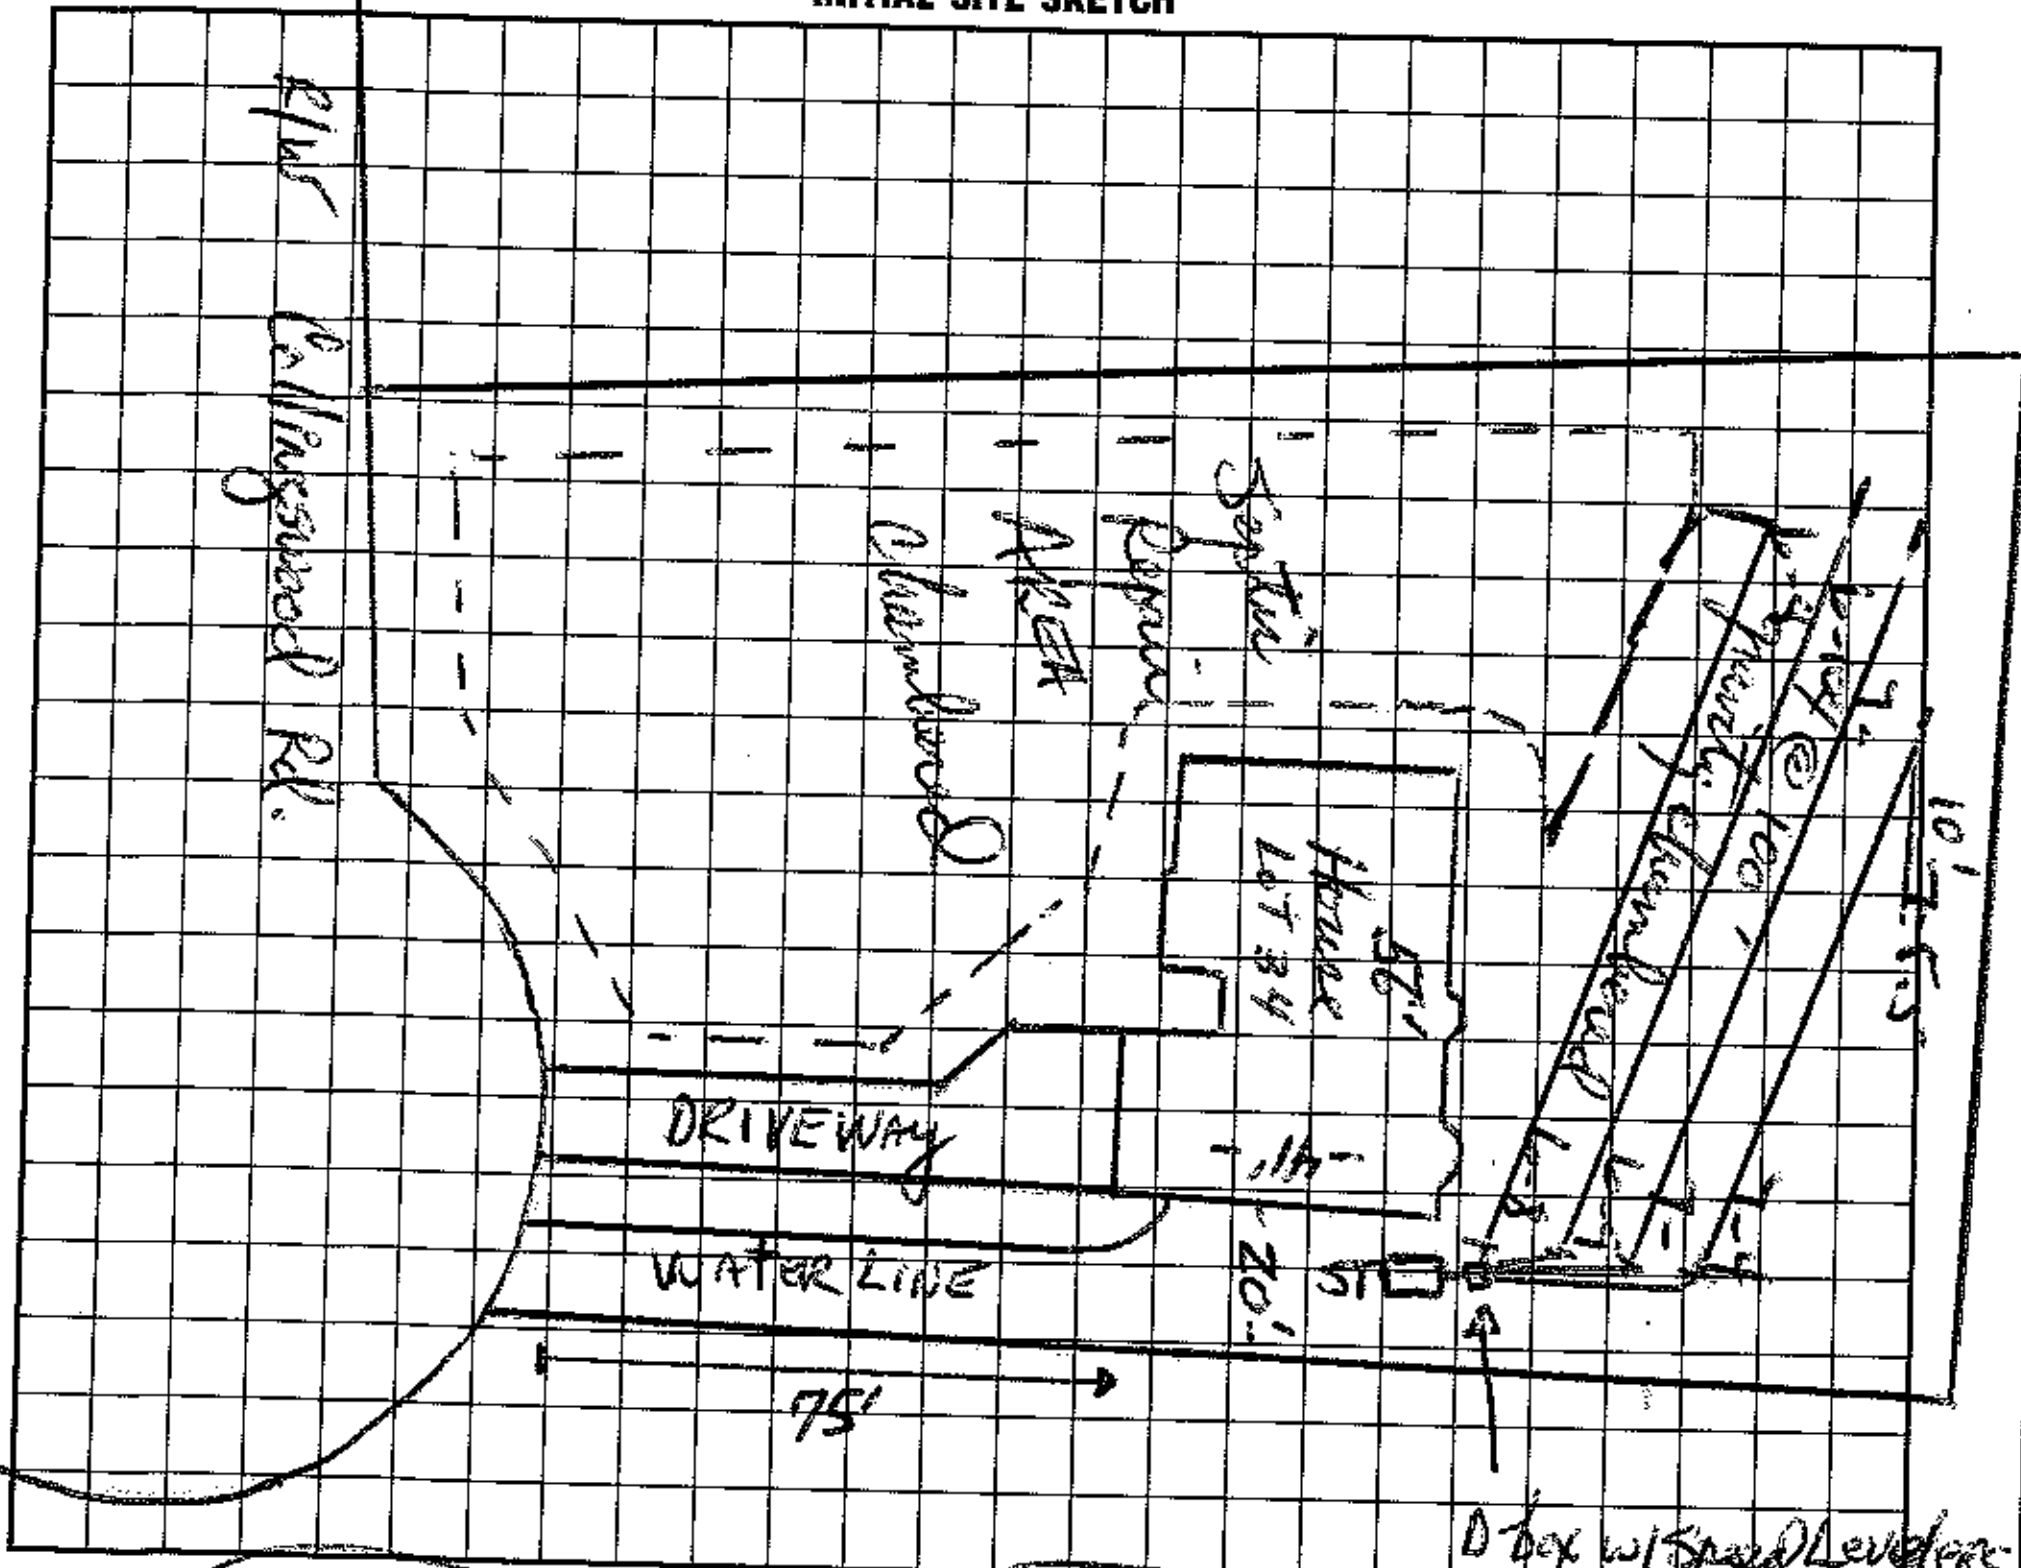

AS BUILT SKETCH

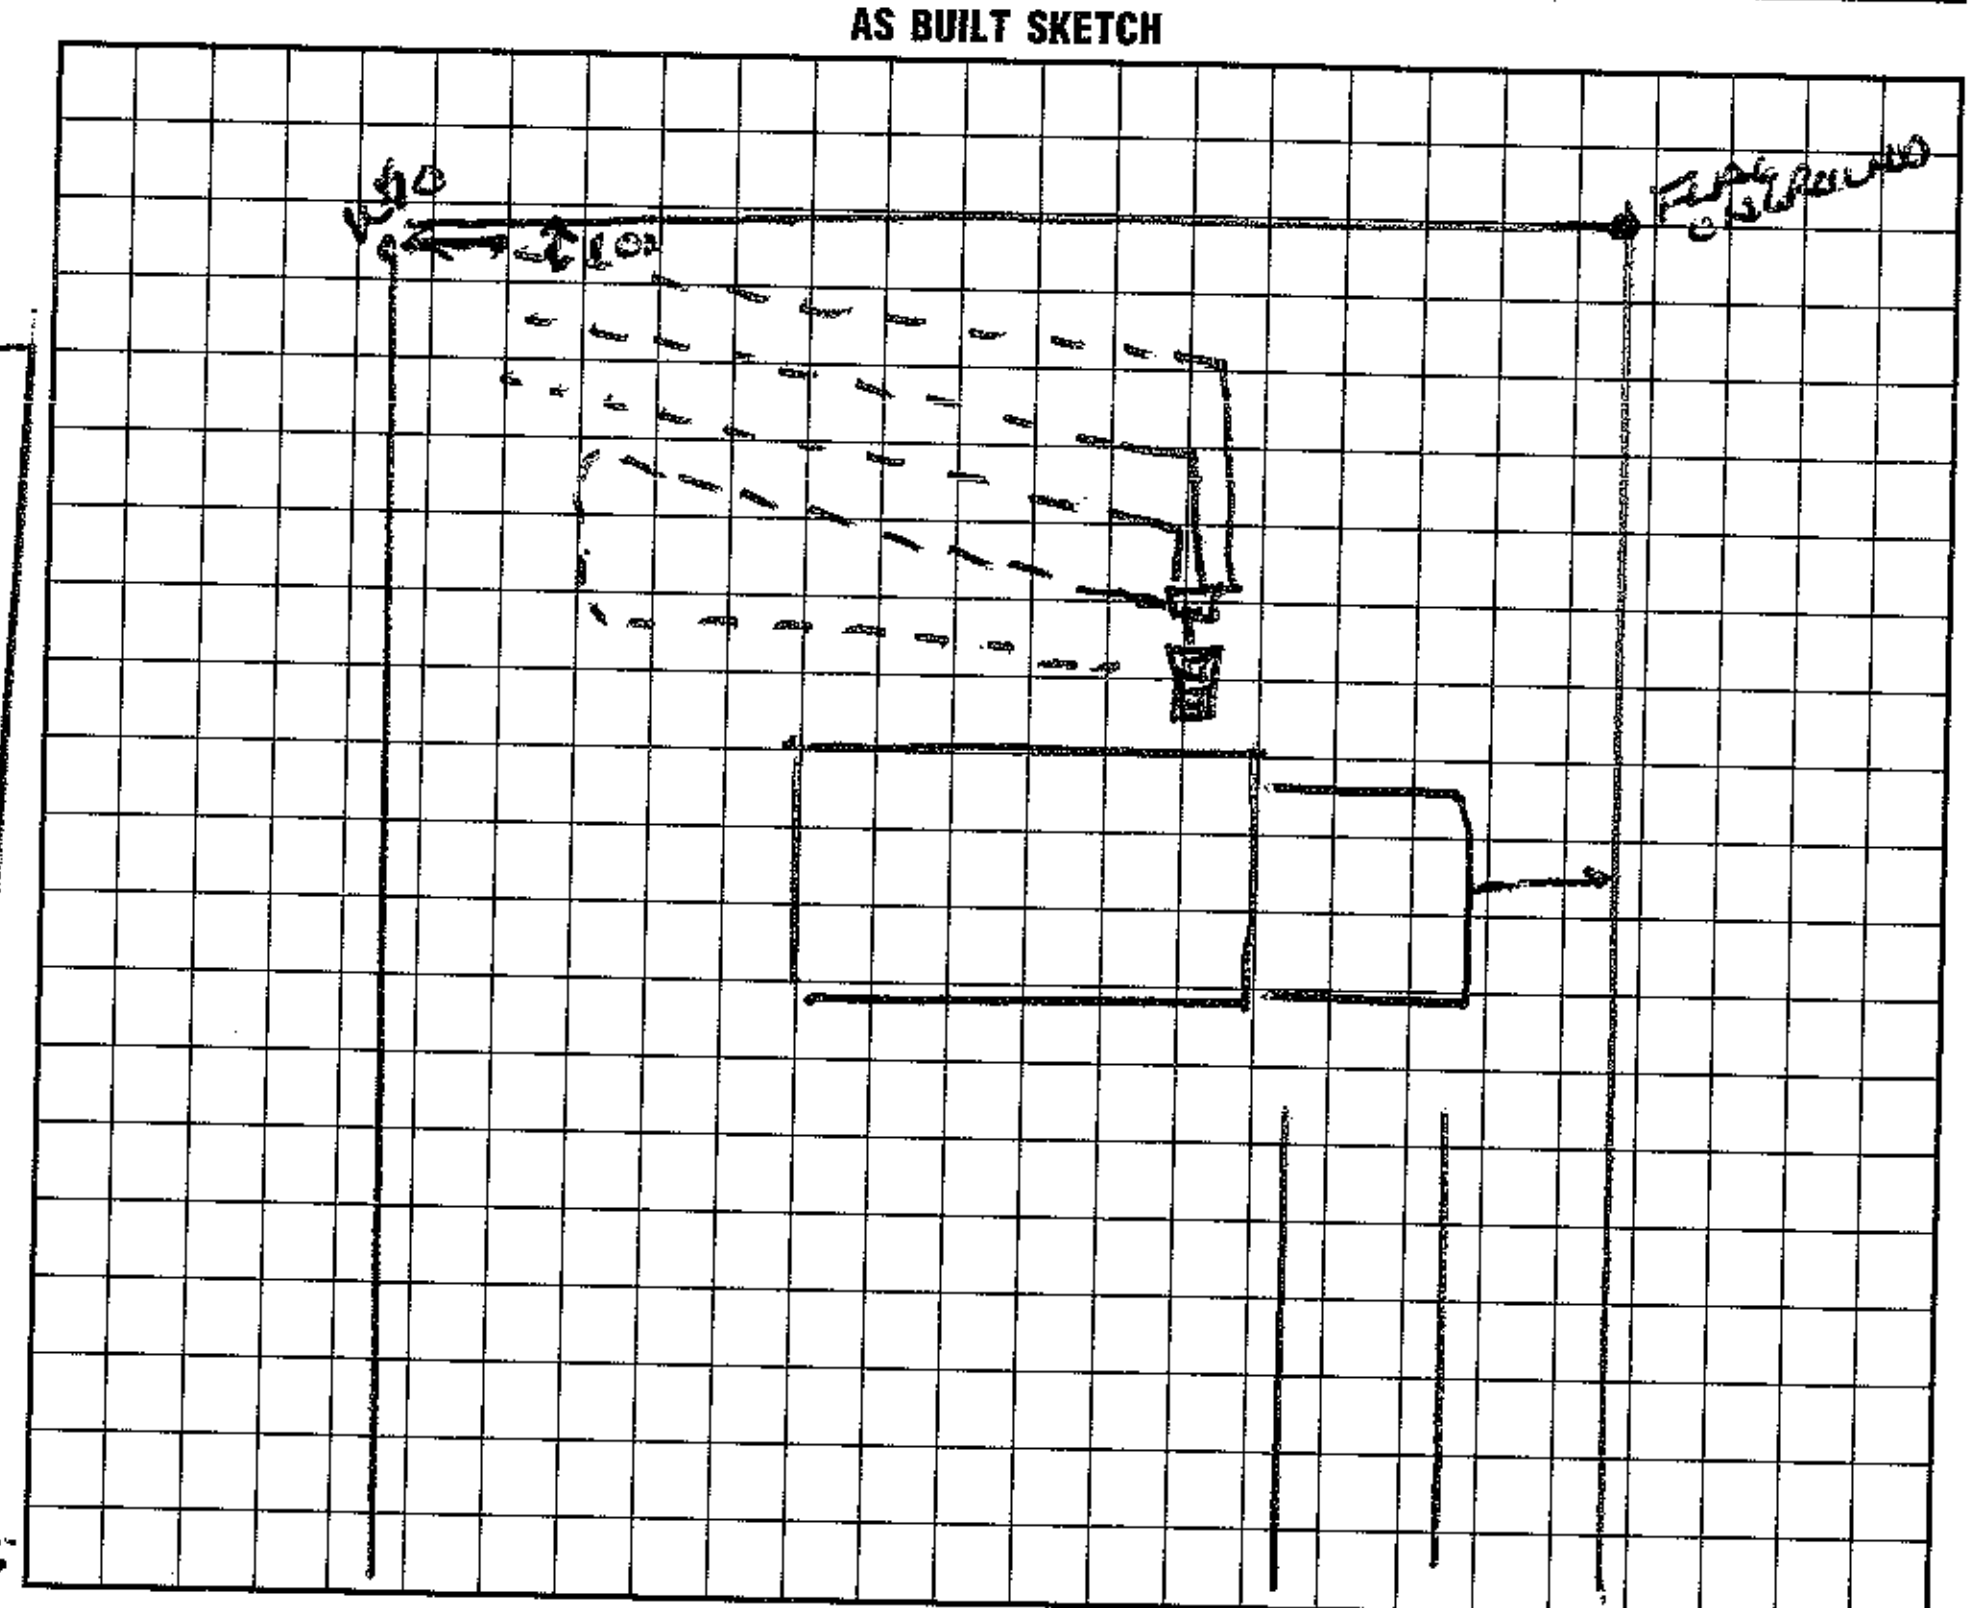

I understand that this permit can be suspended or revoked if any false information is supplied toward securing the permit/any unauthorized changes are made to the site/any unauthorized changes are made in the installation of the system.

Signed: ______

Improvement Permit by: Marvin R. Hinson, RS date 11-5-96

~~Existing System Inspection by:~~ M R Hinson, RS date 11-6-96

Installed by: Rowan Septic Tank

Certificate of Completion by: Wesley Sparks RS. date 6/10/97

Operation Permit by: Wesley Sparks RS. date 6/10/97

HEALTH DEPT. COPY: WHITE INSPECTION COPY (FINAL): GREEN OWNER COPY (FINAL): YELLOW INSPECTION COPY (INITIAL): PINK OWNER COPY (INITIAL): GOLD