IREDELL COUNTY HEALTH DEPARTMENT Const. Auth

STATESVILLE 704-878-5305 MOORESVILLE 704-664-5281

IMPROVEMENT PERMIT / ~~CERTIFICATE OF COMPLETION~~ / OPERATION PERMIT / EXISTING SYSTEM INSPECTION

PROPERTY DESCRIPTION NO. 066584 DATE Nov. 17, '96 TAX MAP NO. ~~4638-74-4716 (pt.)~~ Watershed: ☑ Yes ☐ No

OWNER OR CONTRACTOR Stumpy Creek LLC / HARPER CONST CO. PHONE: Business 633-6124 ~~Home~~ 4638-67-0329

ADDRESS 614 N. Main Salisbury

LOCATION Perth Rd. N. TL Stumpy Creek TL Kuykendall at end

SUBDIVISION Harborview BLOCK / SECTION 1 LOT 13 LOT AREA .95 SITE CLASS. 15 DESIGN FLOW 360 gpd L.T.A.R. ~.3

Septic Tank: 1000 Gallons; STB 794 Date 11/20/99

Pump Tank: _____ Gallons; PT _____ Date _____

Pump Make: _____ Model _____ Serial No. _____

Nitrification Field: No Fields 2 Square Feet 900 Linear Feet 300

No Lines 6 @ 50' Trench Width 36" Max Trench Bottom Depth 24" Gravel Depth NA

☑ New System ☐ Repair System Type: I, II, III, IV, V, VI

System Description: gravity chambered HPS/similar

Repair System Description: SAME - gravel mod.

Maintenance Agreement Required: ☐ Yes ☑ No

☑ House/Mod. Home No. Bedrooms 3

☐ Mobile Home No. Bathrooms 2

☐ Business No. Employees _____

☐ Other _____

☐ Slab ☑ Crawl Space ☐ Basement w/plumbing ☐ Basement wo/plumbing


Water Supply: ☐ Individual ☑ Community ☐ Public

Comments: (3+3)

ONE INSPECTION port per LATERAL

Comments:

INITIAL SITE SKETCH

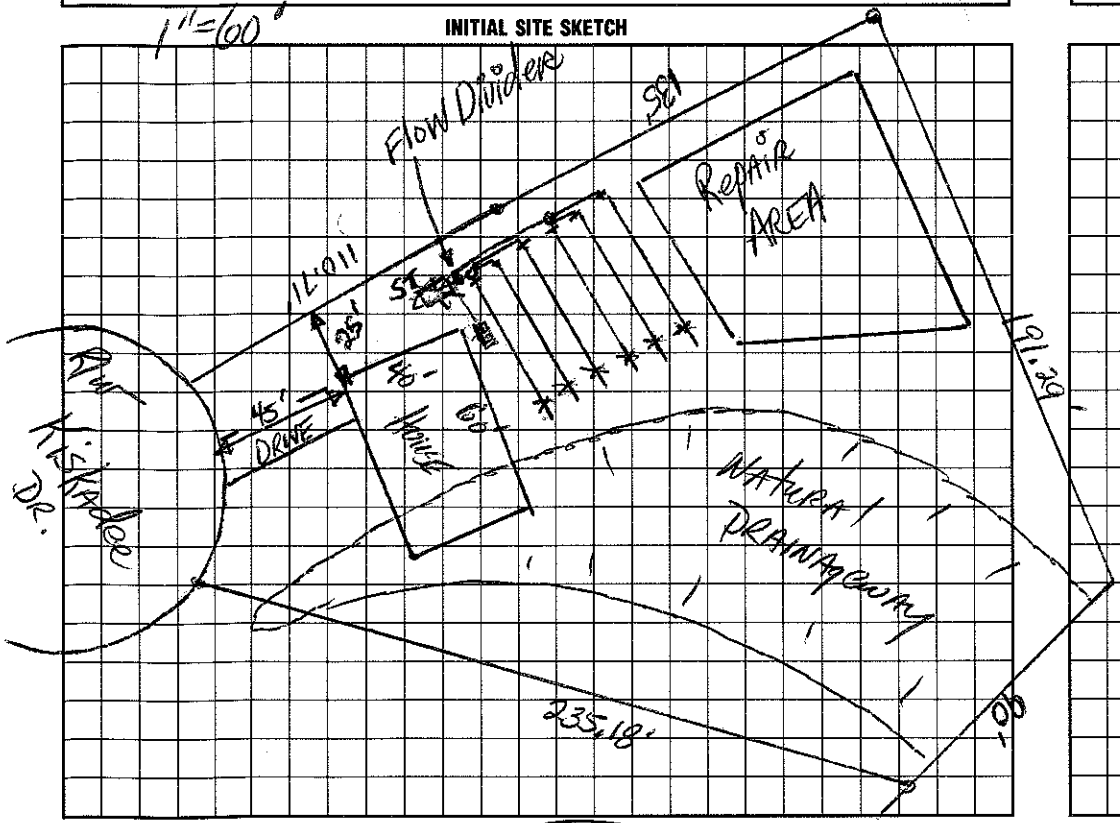

AS BUILT SKETCH

I understand that ~~this permit~~ can be suspended or revoked if any false information is supplied toward securing the permit/any unauthorized changes are made to the site/any unauthorized changes are made in the installation of the system. Improvement Permit is valid for 60 months from date of issuance.

Signed: _____

Improvement Permit by: _____ date 11-17-97

~~Existing System Inspection by:~~ Construction Authorization _____ date 4/1/98

Installed by: Larry Beam

Certificate of Completion by: Wesley Sparks R.S. date 3/7/00

Operation Permit by: _____ date _____

HEALTH DEPT. COPY: WHITE INSPECTION COPY (FINAL): GREEN OWNER COPY (FINAL): YELLOW INSPECTION COPY (INITIAL): PINK OWNER COPY (INITIAL): GOLD