IREDELL COUNTY HEALTH DEPARTMENT Const. Auth. STATESVILLE 704-878-5305 MOORESVILLE 704-664-5281

IMPROVEMENT PERMIT / ~~CERTIFICATE OF COMPLETION~~ / OPERATION PERMIT / EXISTING SYSTEM INSPECTION

PROPERTY DESCRIPTION NO. 066580 DATE Nov. 17, 97 TAX MAP NO. ~~4638774746~~ (pt) Watershed: ☑ Yes ☐ No

OWNER OR CONTRACTOR Stumpy Creek LLC PHONE: Business 633-6124 ~~Home~~ 4638-67-0923

ADDRESS 614 N. Main Salisbury

LOCATION Perth Rd N. to Stumpy Creek to Kiskadee on right

SUBDIVISION Harborview BLOCK / SECTION 4 LOT 9 LOT AREA .07 Ac SITE CLASS. PS DESIGN FLOW 360 gpd L.T.A.R. ~.3

Septic Tank: 1000 Gallons; STB 794 Date 6/23/98

Pump Tank: ____ Gallons; PT ____ Date ____

Pump Make: ____ Model ____ Serial No. ____

Nitrification Field: No Fields 1 Square Feet 720 Linear Feet 400

No Lines 4@100' Trench Width 36" Max Trench Bottom Depth 24" Gravel Depth 12"

☑ New System ☐ Repair System Type: I, II, III, IV, V, VI

System Description: gravity conventional

Repair System Description: gravity/pumped conventional

Maintenance Agreement Required: ☐ Yes ☐ No

☑ House/Mod. Home No. Bedrooms 3

☐ Mobile Home No. Bathrooms 2

☐ Business No. Employees ____

☐ Other ____

☐ Slab ☑ Crawl Space ☐ Basement w/plumbing ☐ Basement wo/plumbing


Water Supply:
☐ Individual
☑ Community
☐ Public

Comments:

Comments:

1"=60'

INITIAL SITE SKETCH

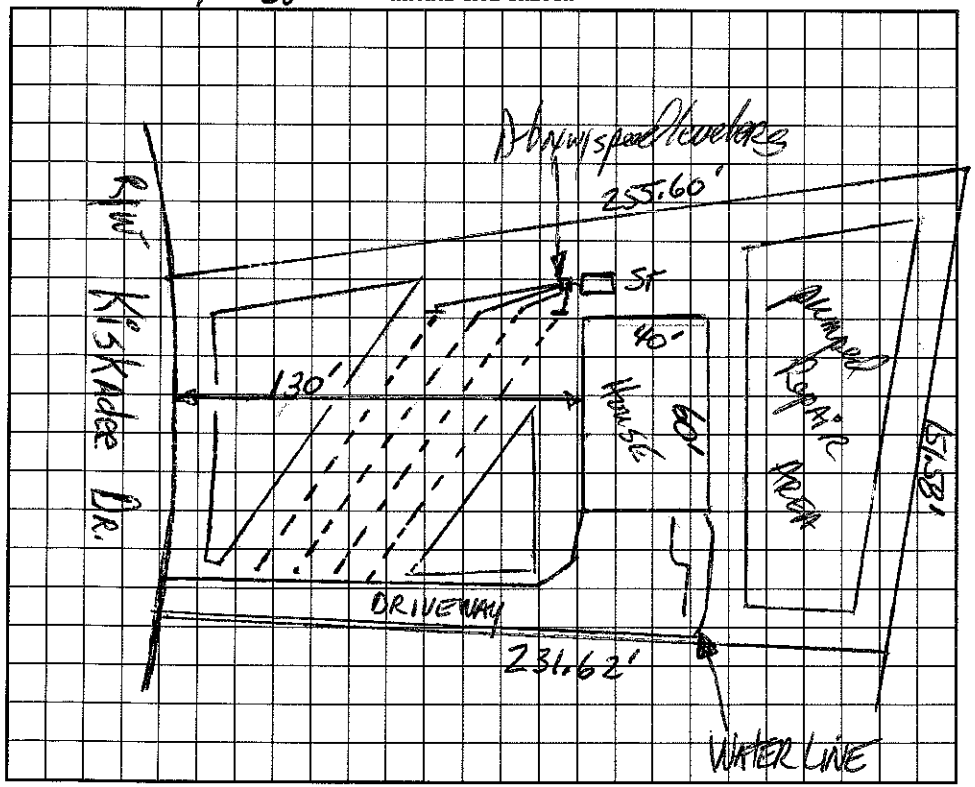

AS BUILT SKETCH

I understand that this ~~permit~~ can be suspended or revoked if any false information is supplied toward securing the permit/any unauthorized changes are made to the site/any unauthorized changes are made in the installation of the system. Improvement Permit is valid for 60 months from date of issuance.

Signed: ____

Improvement Permit by: ____ date 11-17-97

~~Existing System Inspection by:~~ Construction Authorization by: ____ date 4/1/98

Installed by: LARRY BEAM

Certificate of Completion by: ____ date ____

Operation Permit by: ____ date 9/30/04

HEALTH DEPT. COPY: WHITE INSPECTION COPY (FINAL): GREEN OWNER COPY (FINAL): YELLOW INSPECTION COPY (INITIAL): PINK OWNER COPY (INITIAL): GOLD