# IREDELL COUNTY HEALTH DEPARTMENT

STATESVILLE 704-878-5305 MOORESVILLE 704-664-5281

Valid for 6 months

## IMPROVEMENT PERMIT / AUTHORIZATION TO CONSTRUCT / OPERATION PERMIT / EXISTING SYSTEM INSPECTION

PERMIT# 122210 PIN# 4638672362 Carol Laney-Realtor DATE 9-20-04

OWNER OR CONTRACTOR John Edwards PHONE: Business 704-451-2101 Home 561-967-2688

ADDRESS 1561 Rudza Rd West Palm Beach FL

LOCATION Hwy 150 West TR Perth Rd TL Stumpy Creek TL Collingswood to end in cul-de-sac

SUBDIVISION C.W.& T BLOCK / SECTION 14 LOT 1053 LOT AREA .75 acre + SITE CLASS. PS DESIGN FLOW 360gpd L.T.A.R. —

Septic Tank: 1000 Exist Gallons; STB — Date —

Pump Tank: — Gallons; PT — Date —

Pump Make: — Model — Serial No. —

Nitrification Field: No Fields 1 Square Feet 300' Linear Feet 150'

No. Lines 1-150' Trench Width 24" Max Trench Bottom Depth 3 Gravel Depth N/A

EXIST

☐ New System ☐ Repair System Type: I, II, (III), IV, V, VI

System Description: Existing Gravity-Panel Block

Repair System Description: Pump-Panel Block

Maintenance Agreement Required: ☐ Yes ☒ No Not initially

☐ House/Mod. Home ☒ Mobile Home ☐ Business ☐ Other

No. Bedrooms 3 No. Bathrooms 3 No. Employees —


☐ Slab ☒ Crawl Space ☐ Basement w/plumbing ☐ Basement wo/plumbing

Water Supply: ☒ Individual ☐ Public ☐ Community


Comments/Conditions: Existing Septic System appears to be functioning okay at time of inspection. Okay to replace MH with 3 Bedroom home in same location.

Comments/Conditions: * Note: Owner may be able to use area of existing MH for future repair if future house is built in designated repair area.

INITIAL SITE SKETCH

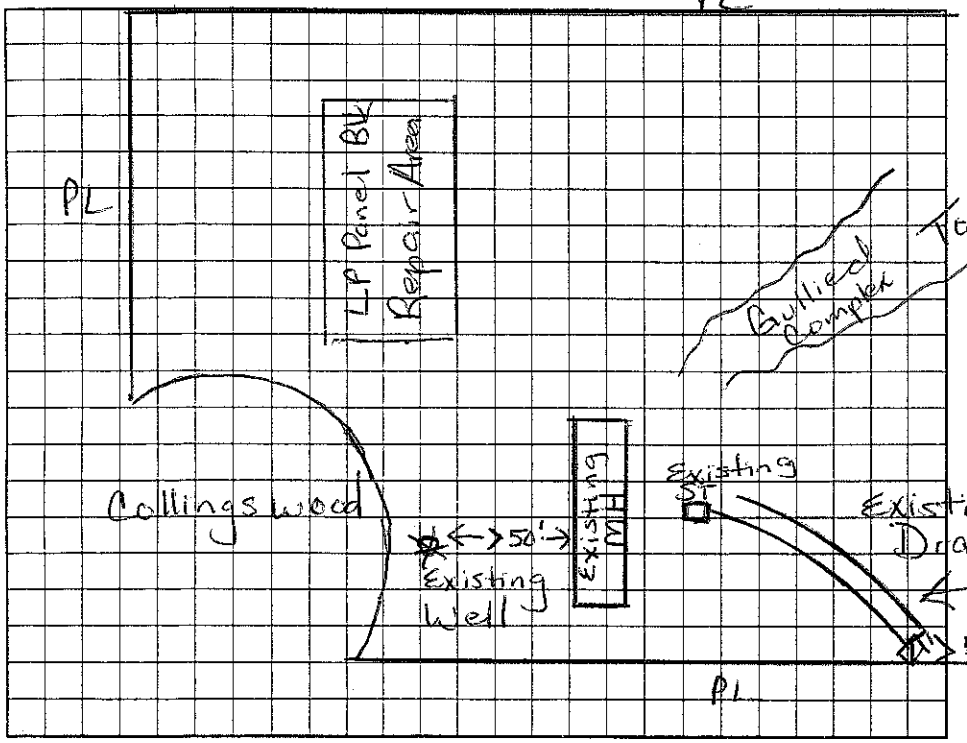


AS BUILT SKETCH

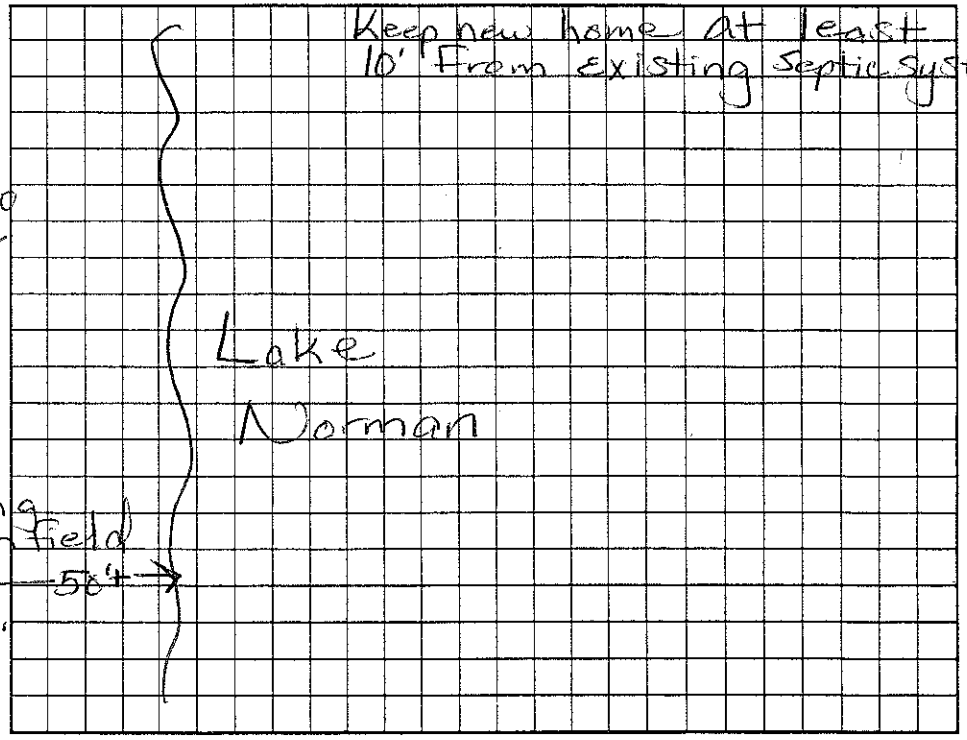


Permit can be suspended or revoked if any false information is supplied toward securing the permit/any unauthorized changes are made to the site/any unauthorized changes are made in the installation of the system. Improvement Permit with plat valid without expiration. Improvement Permit with site plan valid for sixty months. Authorization to Construct is valid for a period equal to that of Improvement Permit – not to exceed sixty months.

Signed Carol Laney Agent date 9/21/04

Improvement Permit by: Myra H. Dotson RS date 9/21/04

Authorization to Construct by: — date —

Installed by: —

Operation Permit by: — date —

Existing System Inspection by: Myra H. Dotson RS date 9/21/04

HEALTH DEPT. COPY: WHITE OWNER COPY (FINAL): YELLOW OWNER COPY (INITIAL): PINK