IREDELL COUNTY HEALTH DEPARTMENT

STATESVILLE 704-878-5305 MOORESVILLE 704-664-5281

Valid for 16 months

IMPROVEMENT PERMIT / AUTHORIZATION TO CONSTRUCT / OPERATION PERMIT / EXISTING SYSTEM INSPECTION

PERMIT# 122210 PIN# 4638 67 2362 Carl Laney-Realtor DATE 9-20-04

OWNER OR CONTRACTOR John Edwards PHONE: Business 704-451-2101 Home 561-967-2688

ADDRESS 1561 Kurtz Rd West Palm Beach FL

LOCATION Hwy 150 West TR Perth Rd TL Stumpy Creek TL Cullingswood to end in cul-de-sac

SUBDIVISION C.W.S. I BLOCK / SECTION 14 LOT 1053 LOT AREA .75ac+ SITE CLASS PS DESIGN FLOW 3 bdrm L.T.A.R.

Septic Tank: 100 Exist Gallons; STB Date

Pump Tank: Gallons; PT Date

Pump Make: Model Serial No.

Nitrification Field: No Fields 1 Square Feet 300' Linear Feet 150'

No. Lines 1-150' Trench Width 24" Max Trench Bottom Depth 3' Gravel Depth N/A

☐ New System ☐ Repair System Type: I, II, III, IV, V, VI

System Description: Existing Gravity-Pump-Pump Block

Repair System Description: Pump-Pump Block

Maintenance Agreement Required: ☐ Yes ☒ No Not Applicable

☐ House/Mod. Home ☒ Mobile Home ☐ Business ☐ Other

No. Bedrooms 3 No. Bathrooms 3 No. Employees


☐ Slab ☒ Crawl Space ☐ Basement w/plumbing ☐ Basement wo/plumbing

Water Supply: ☒ Individual ☐ Public ☐ Community


Comments/Conditions: Existing Septic System appears to be functioning Okay at time of inspection. Okay to replace MH with 3 Bedroom home in same location. *Not to Scale

Comments/Conditions: * Note: Owner may be able to use area of existing MH for future repair if future house is built in designated repair area.

INITIAL SITE SKETCH

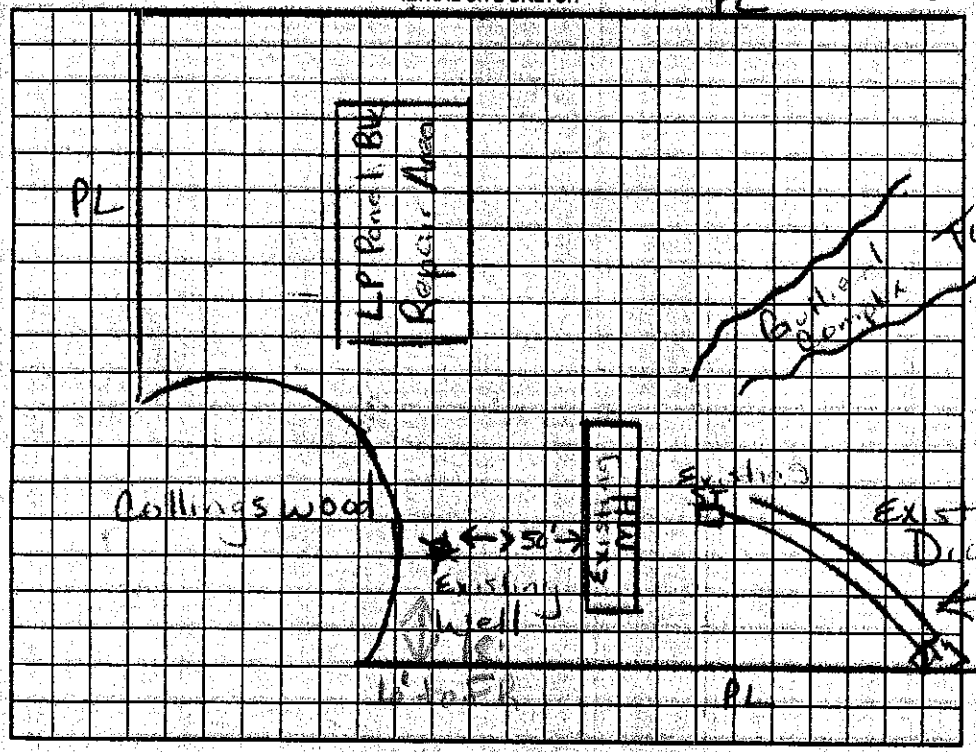

AS BUILT SKETCH

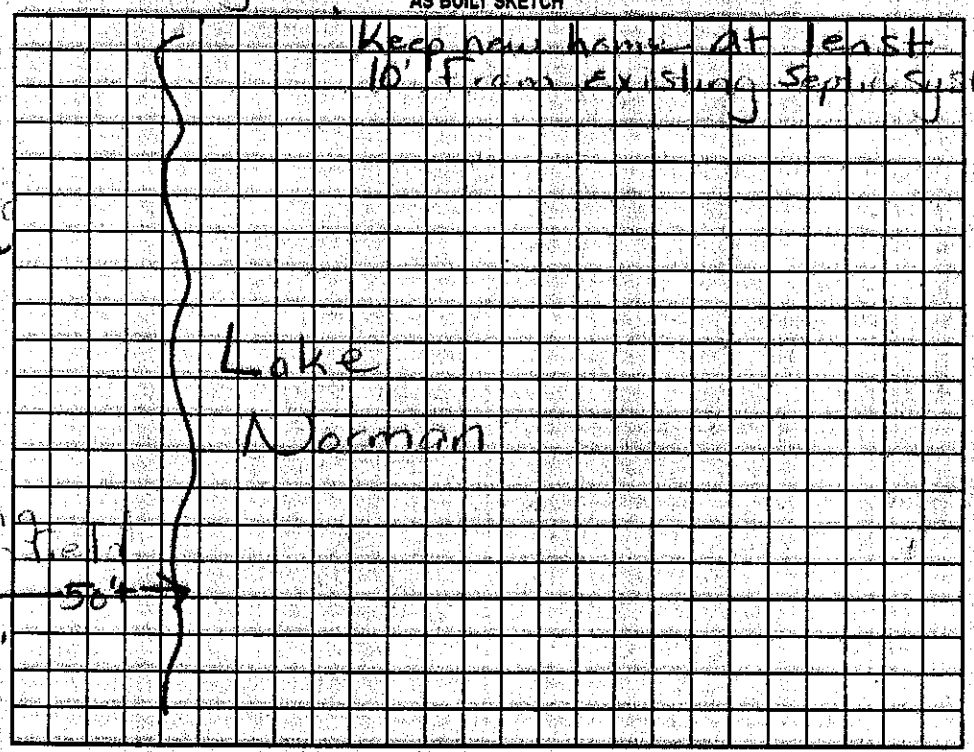

Permit can be suspended or revoked if any false information is supplied toward securing the permit/any unauthorized changes are made to the site/any unauthorized changes are made in the installation of the system. Improvement Permit with plat valid without expiration. Improvement Permit with site plan valid for sixty months. Authorization to Construct is valid for a period equal to that of Improvement Permit – not to exceed sixty months.

Signed: date 9-21-04

Improvement Permit by: date 9/21/04

Authorization to Construct by: date

Installed by:

Operation Permit by: date

Existing System Inspection by: date 9/21

HEALTH DEPT. COPY: WHITE OWNER COPY (FINAL): YELLOW OWNER COPY (INITIAL): PINK