IREDELL COUNTY HEALTH DEPARTMENT

STATESVILLE 704-878-5305 MOORESVILLE 704-664-5281

IMPROVEMENT PERMIT / AUTHORIZATION TO CONSTRUCT / OPERATION PERMIT / EXISTING SYSTEM INSPECTION

PERMIT# 066590 PIN# ~~4638771946 PC~~ 4638-67-3981 DATE 7/2/98

OWNER OR CONTRACTOR LAKEMONT HOMES PHONE: Business 339-7998 Home 0

ADDRESS PO BOX 1463 MATTHEWS NC 28105

LOCATION PERMIT PD- TL STUMPY CREEK - TL KISKADEE ON LT.

SUBDIVISION HARBORVIEW BLOCK / SECTION 9 LOT 19&20 LOT AREA 1.66AC SITE CLASS. PS DESIGN FLOW 360 L.T.A.R. .30RD/FT2

Septic Tank: 1000 Gallons; STB 794 Date 5/12/98
Pump Tank: ____ Gallons; PT ____ Date ____
Pump Make: ____ Model ____ Serial No. ____
Nitrification Field: No Fields 1 Square Feet 1200 Linear Feet 400
No Lines 6 Trench Width 36" Max Trench Bottom Depth 36" Gravel Depth 12"

☑ New System ☐ Repair System Type: I (II) III, IV, V, VI
System Description: GRAVITY CONVENTIONAL
Repair System Description: SAME
Maintenance Agreement Required: ☐ Yes ☑ No


☑ House/Mod. Home No. Bedrooms 3
☐ Mobile Home No. Bathrooms 3
☐ Business No. Employees ____
☐ Other ____
☐ Slab ☐ Crawl Space ☑ Basement w/plumbing ☐ Basement wo/plumbing

Water Supply:
☐ Individual
☐ Public
☑ ~~Community~~


Comments:/Conditions:

Comments:/Conditions: (LOT 19 & 20 COMBINED) * 1.66AC

INITIAL SITE SKETCH

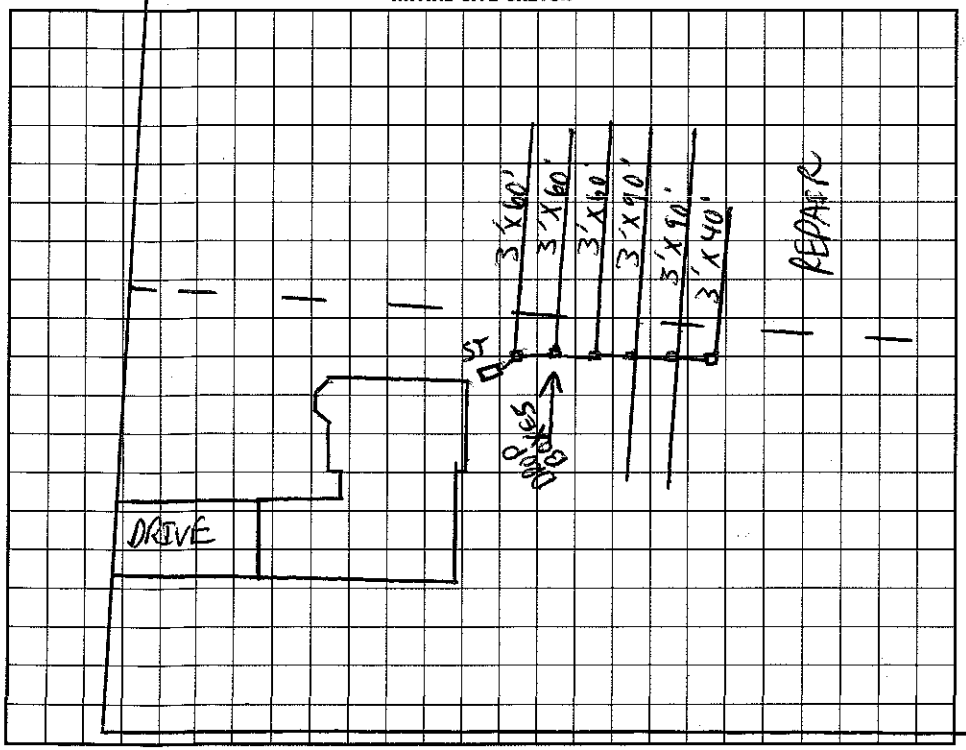

AS BUILT SKETCH

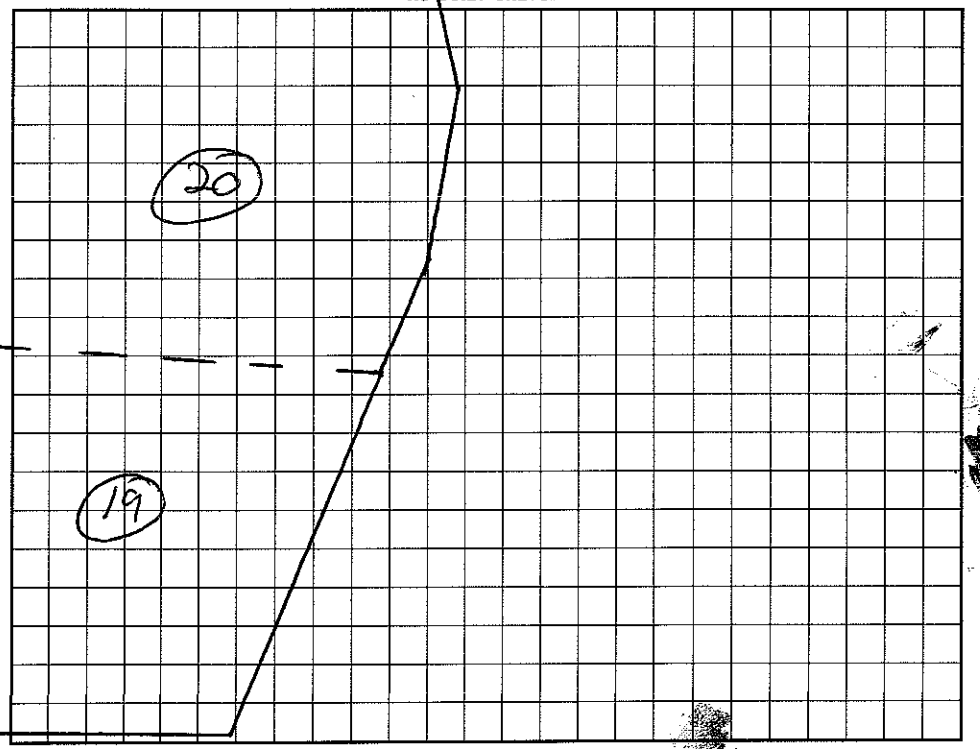

I understand that this permit can be suspended or revoked if any false information is supplied toward securing the permit/any unauthorized changes are made to the site/any unauthorized changes are made in the installation of the system. Improvement Permit with plat valid without expiration. Improvement Permit with site plan valid for sixty months. Authorization to Construct is valid for a period equal to that of Improvement Permit – not to exceed sixty months.

Signed: ____ date 8/14/98
Improvement Permit by: C. Ray Tran RS date 7/2/98
Authorization to Construct by: C. Ray Tran RS date 7/2/98

Installed by: LARRY BRAM
Operation Permit by: C. Ray Tran date 8/21/98
Existing System Inspection by: ____ date ____

HEALTH DEPT. COPY: WHITE INSPECTION COPY (FINAL): GREEN OWNER COPY (FINAL): YELLOW INSPECTION COPY (INITIAL): PINK OWNER COPY (INITIAL): GOLD