IREDELL COUNTY HEALTH DEPARTMENT

STATESVILLE 704-878-5305 MOORESVILLE 704-664-5281

IMPROVEMENT PERMIT / CERTIFICATE OF COMPLETION / OPERATION PERMIT / EXISTING SYSTEM INSPECTION

PROPERTY DESCRIPTION NO. 25363 DATE 12/18/96 TAX MAP NO. 25-A-51 pt of 4638 67 5290 Watershed: ☑ Yes ☐ No

OWNER OR CONTRACTOR STUMPY CREEK LLC / JUDY DINKINS PHONE: Business 633-6124 Home

ADDRESS 614 N MAIN ST SALISBURY NC 28144

LOCATION PELTH RD TL EAST HEDGEWAY LN (SEA TRAIL DR) at end 174 Sea Trail Dr

SUBDIVISION HARBOR VIEW BLOCK / SECTION 6 LOT 13 LOT AREA 23371 FT² SITE CLASS. RS DESIGN FLOW 480GPD L.T.A.R. .36 PD/FT²

Septic Tank: 1000 Gallons; STB 10-28-01 Date → 794

Pump Tank: 1000 Gallons; PT 7-13-01 Date → 283

Pump Maker Myers Model P102 Serial No. 9101

Nitrification Field: No Fields 1 Square Feet 1200 Linear Feet 400

No Lines 5 Trench Width 36" Max Trench Bottom Depth 24" Gravel Depth N/A

☑ New System ☐ Repair System Type: I, II, III, IV, V, VI

System Description: PUMP CHAMBER ORSENET

Repair System Description: PUMP PANEL

Maintenance Agreement Required: ☐ Yes ☑ No

☑ House/Mod. Home ☐ Mobile Home ☐ Business ☐ Other

No. Bedrooms 4 No. Bathrooms 4 No. Employees

☐ Slab ☑ Crawl Space ☐ Basement w/plumbing ☐ Basement wo/plumbing


Water Supply: ☐ Individual ☑ Community ☐ Public

Comments:


Comments: Checked lines 3/7/2002 MD
Pres., electrical & alarm 4/23/2002

INITIAL SITE SKETCH

1" = 100'

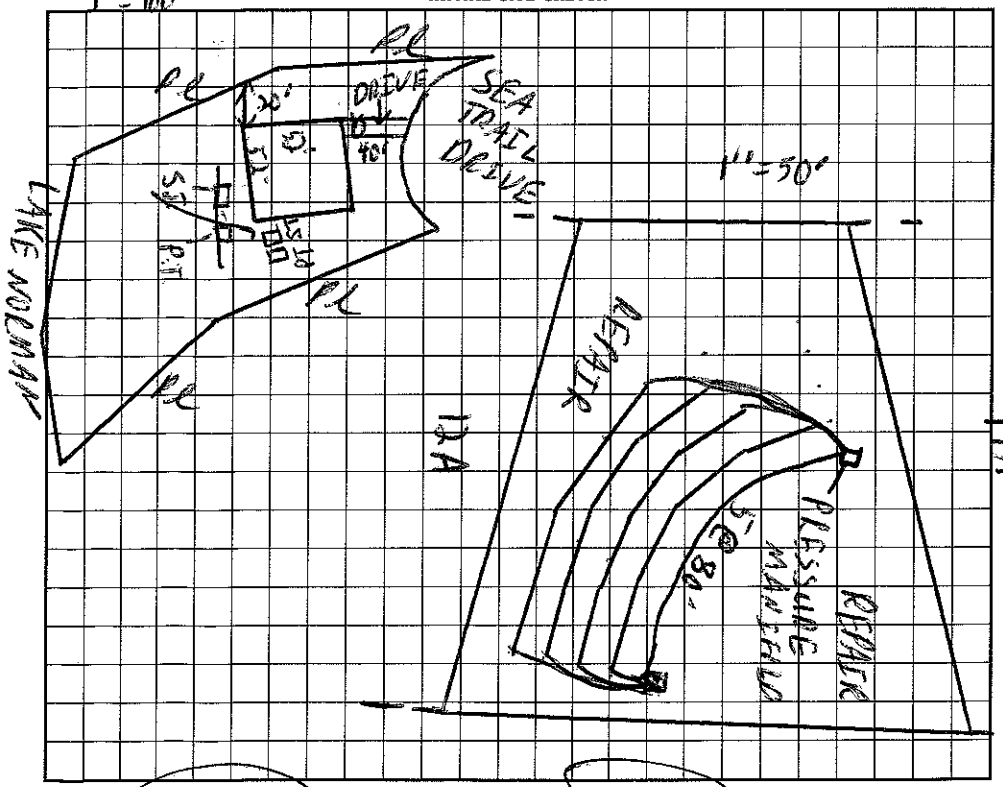

AS BUILT SKETCH

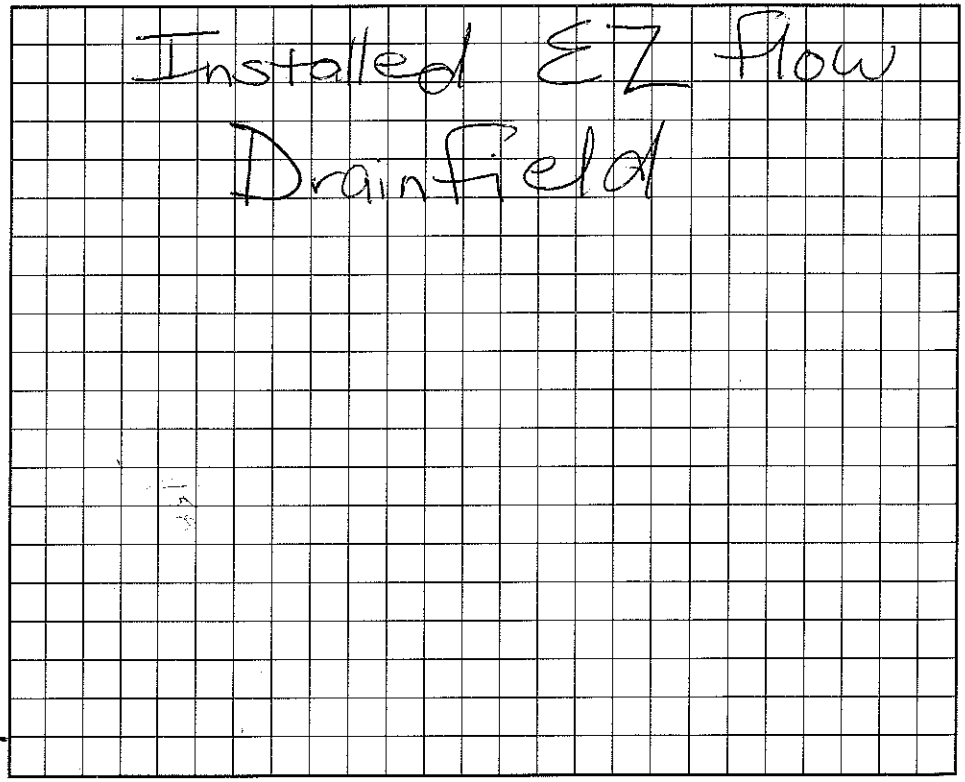

I understand that this permit can be suspended or revoked if any false information is supplied toward securing the permit/any unauthorized changes are made to the site/any unauthorized changes are made in the installation of the system.

Signed:

Improvement Permit by: C Blythe EHS date 12/18/96

Existing System Inspection by: C Blythe RS date 5/9/01

Installed by: R&H

Certificate of Completion by: Maria H Watson RS date 4/22/2002

Operation Permit by: Maria H Watson RS date 4/22/2002

HEALTH DEPT. COPY: WHITE INSPECTION COPY (FINAL): GREEN OWNER COPY (FINAL): YELLOW INSPECTION COPY (INITIAL): PINK OWNER COPY (INITIAL): GOLD