STATESVILLE 704-878-5305 MOORESVILLE 704-664-5281

CERTIFICATE OF COMPLETION / OPERATION PERMIT / EXISTING SYSTEM INSPECTION

PROPERTY DESCRIPTION NO. 25364 DATE 12/18/96 TAX MAP NO. 25A-51 pt of 4638675383 Watershed: ☒ Yes ☐ No

OWNER OR CONTRACTOR STUMPY CREEK LLC (JOHN WPSON) PHONE: Business 633-6124 Home

ADDRESS 614 N MAIN ST SALISBURY NC 28144

LOCATION PERTH LD - TL AFTER HIDEAWAY ON SEA TRAIL DR. ON LT 170 Sea Trail Dr.

SUBDIVISION HARBORVIEW BLOCK / SECTION 6 LOT 142 LOT AREA 25,660 FT± SITE CLASS. PS DESIGN FLOW 480 GPD L.T.A.R. .35 GPD/FT²

Septic Tank: 1000 Gallons; STB 10/24 Date 7/1/99

Pump Tank: 1000 Gallons; PT 1/4 Date 12/15/98

Pump Make: HYDROMATIC Model Serial No.

Nitrification Field: No Fields 1 Square Feet 1035 Linear Feet 345

No Lines 3 Trench Width 36" Max Trench Bottom Depth 36" Gravel Depth N/A

☒ New System ☐ Repair System Type: I, II, III, IV, V, VI

System Description: PUMP CHAMBERED OR STRIPE

Repair System Description: PUMP PANEL

Maintenance Agreement Required: ☐ Yes ☒ No

☒ House/Mod. Home No. Bedrooms 4

☐ Mobile Home No. Bathrooms 2

☐ Business No. Employees

☐ Other

☐ Slab ☒ Crawl Space ☒ Basement w/plumbing ☐ Basement wo/plumbing


Water Supply: ☐ Individual ☒ Community ☐ Public

Comments: OFF-SITE INITIAL SYSTEM AND REPAIR.


SEE MASTER PLAN FOR COLOR CODE SUPPLY LINES.

Comments: Pressure/manifold lines

INITIAL SITE SKETCH

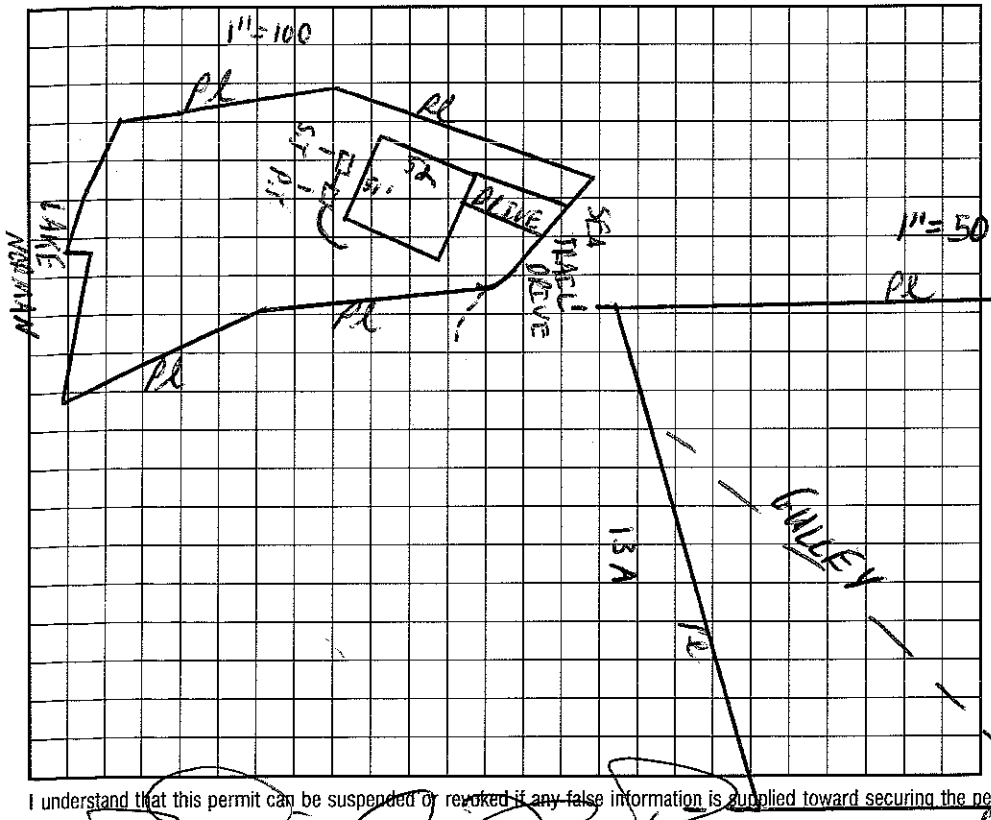

AS BUILT SKETCH

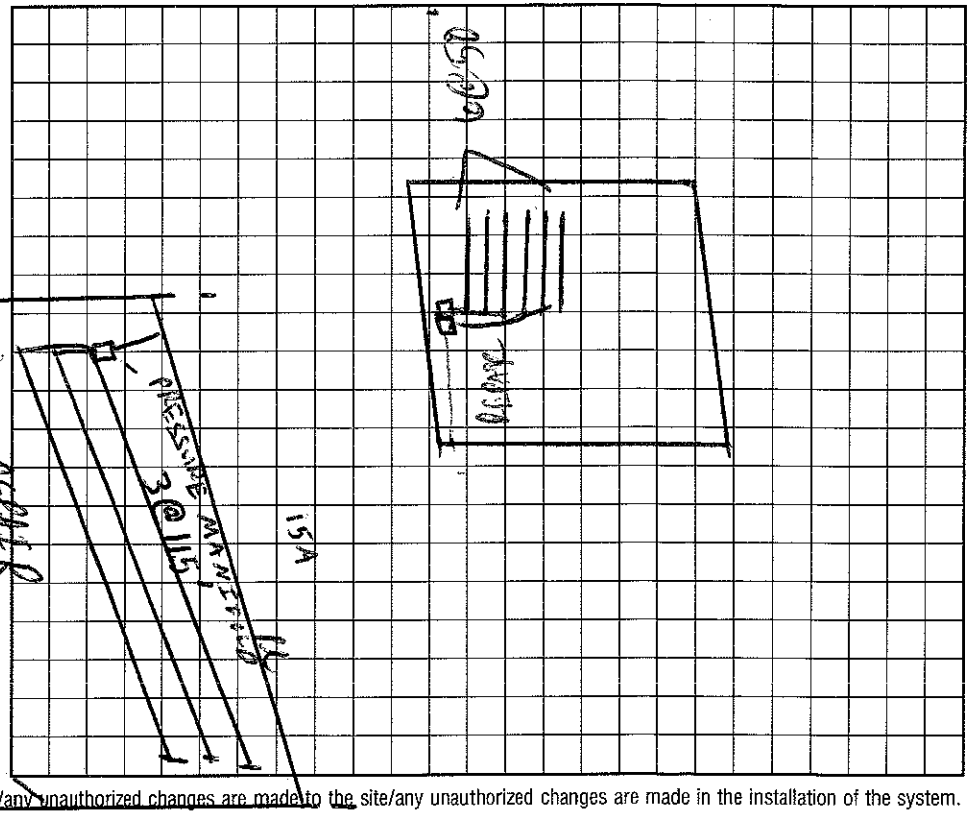

I understand that this permit can be suspended or revoked if any false information is supplied toward securing the permit/any unauthorized changes are made to the site/any unauthorized changes are made in the installation of the system.

Signed:

Installed by: C+W Grading

Improvement Permit by: C Rhyne EHS date 12/18/96

Existing System Inspection by: C Rhyne RS date 1/5/99

Certificate of Completion by: Wesley Sparks RS date 12/22/99

Operation Permit by: date

HEALTH DEPT. COPY: WHITE INSPECTION COPY (FINAL): GREEN OWNER COPY (FINAL): YELLOW INSPECTION COPY (INITIAL): PINK OWNER COPY (INITIAL): GOLD