4.000

IREDELL COUNTY HEALTH DEPARTMENT

STATESVILLE 704-878-5305 MOORESVILLE 704-664-5281

IMPROVEMENT PERMIT / CERTIFICATE OF COMPLETION / OPERATION PERMIT / EXISTING SYSTEM INSPECTION

PROPERTY DESCRIPTION NO. 25366 90311 DATE 12/18/96 TAX MAP NO. 25-A-51 pt of 4638675599 Watershed: ☑ Yes ☐ No

OWNER OR CONTRACTOR STUMPY CREEK LLC PHONE: Business 633-8124 Home

ADDRESS 614 N MAIN ST SALISBURY NC 28144

LOCATION PERTH RD - TL PAST HIDEAWAY (SEA TRAIL DR) - ON RT NEAR END

SUBDIVISION HARBORVIEW BLOCK / SECTION 07 LOT 16+16A LOT AREA - SITE CLASS. PS DESIGN FLOW 480 GPD L.T.A.R. .3 gpd/ft²

Septic Tank: 1000 Gallons; STB 5-11-00 Date 825

Pump Tank: 1000 Gallons; PT 7-11-00 Date 302

Pump Make: Hydromatic Model SHEF50 Serial No. 7/00

Nitrification Field: No Fields 1 Square Feet 1206 Linear Feet 402

No Lines 6 Trench Width 36" Max Trench Bottom Depth 24" Gravel Depth N/A

☑ New System ☐ Repair System Type: I, II, III, IV, V, VI

System Description: PUMP CHAMBERED OR SIMILAR

Repair System Description: PUMP PANEL

Maintenance Agreement Required: ☐ Yes ☑ No

☑ House/Mod. Home No. Bedrooms 4

☐ Mobile Home No. Bathrooms 4

☐ Business No. Employees

☐ Other

☐ Slab ☑ Crawl Space ☐ Basement w/plumbing ☐ Basement wo/plumbing

Water Supply: ☐ Individual ☑ Community ☐ Public

Comments: OFF-SITE INITIAL AND REPAIR


SEE MASTER PLAN FOR COLOR CODE SUPPLY LINES.

Comments: Uppermost line may be in some fill material


Tanks & lines inspection 9/100 mf

Check to make sure filter installed

INITIAL SITE SKETCH

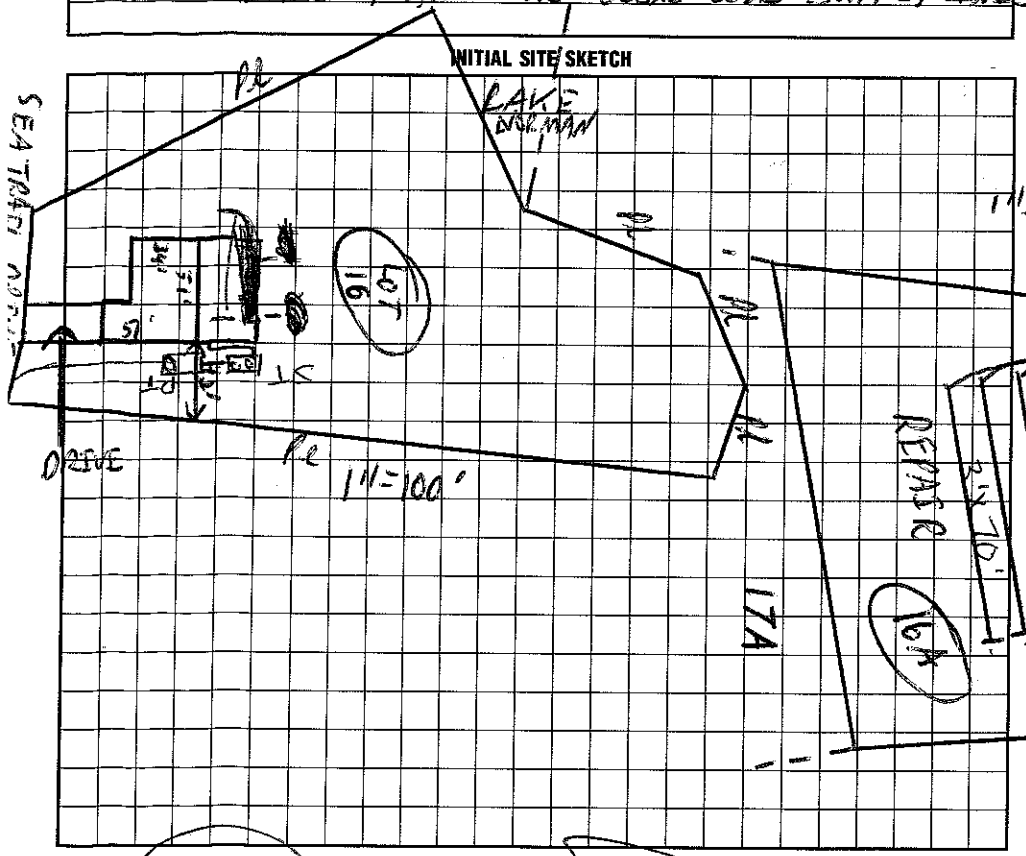

AS BUILT SKETCH

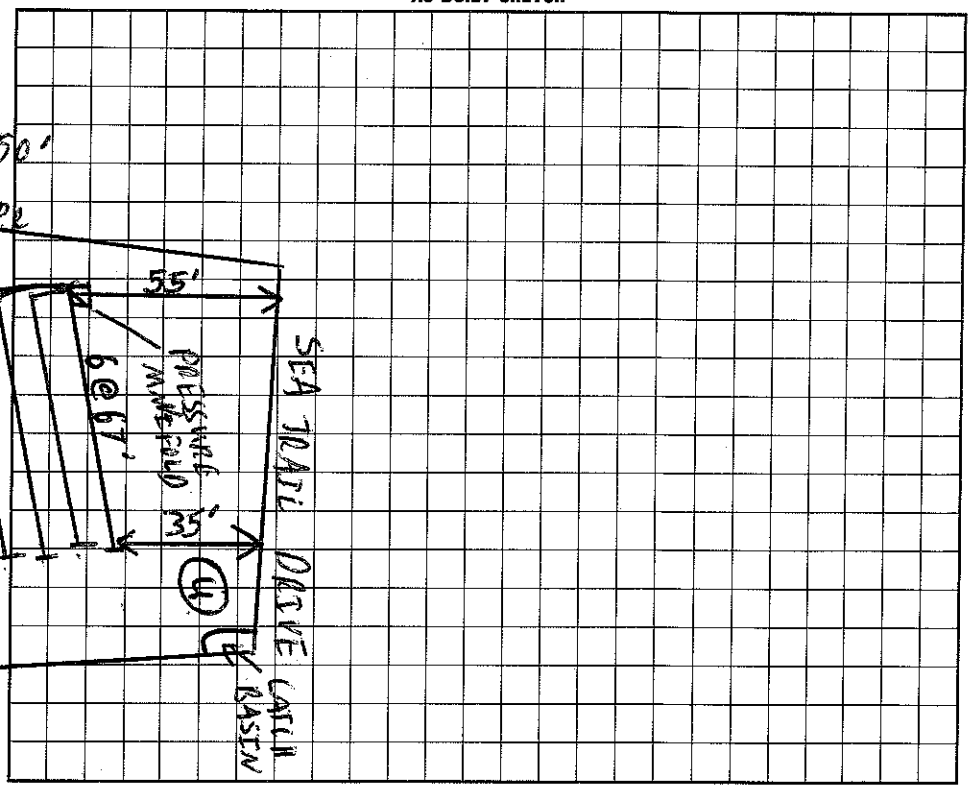

I understand that this permit can be suspended or revoked if any false information is supplied toward securing the permit/any unauthorized changes are made to the site/any unauthorized changes are made in the installation of the system.

Signed:

Improvement Permit by: [illegible] EHSI date 12/18/96

Existing System Inspection by: Authorization PS date 5/31/00

Installed by: C & W Grading

Certificate of Completion by: Wesley Sparks RS. date 11/29/00

Operation Permit by: Wesley Sparks RS. date 11/29/00

HEALTH DEPT. COPY: WHITE INSPECTION COPY (FINAL): GREEN OWNER COPY (FINAL): YELLOW INSPECTION COPY (INITIAL): PINK OWNER COPY (INITIAL): GOLD