IREDELL COUNTY HEALTH DEPARTMENT

STATESVILLE 704-878-5305 MOORESVILLE 704-664-5281

$1130 713

IMPROVEMENT PERMIT / AUTHORIZATION TO CONSTRUCT / OPERATION PERMIT / EXISTING SYSTEM INSPECTION

PERMIT# 116784 PIN# 4638-67-6415 DATE 2/25/04

OWNER OR CONTRACTOR The Maximus Group PHONE: Business 704 662-3633 Home

ADDRESS 378 Williamson Rd Mooresville NC 28117

LOCATION Perth, TL Seatrail At end on ~~LT~~ (RT)

SUBDIVISION Harbor view BLOCK / SECTION 6 LOT 15 LOT AREA 22,874 sf SITE CLASS. PS DESIGN FLOW 480 L.T.A.R. 0.3

Septic Tank: 1000 Gallons; STB ~~1250~~ Date

Pump Tank: 1000 Gallons; PT 32 Date

Pump Make: Goulds Model WE05124 Serial No.

Nitrification Field: No Fields 1 Square Feet 1200 Linear Feet 400

No Lines 4 @ 100 Trench Width 36" Max Trench Bottom Depth 24" Gravel Depth —

☒ New System ☐ Repair System Type: I, II, (III) IV, V, VI

System Description: PM 25% Reduction

Repair System Description: Pump Panel Block

Maintenance Agreement Required: ☐ Yes ☒ No

☒ House/Mod. Home No. Bedrooms 4

☐ Mobile Home No. Bathrooms 4.5

☐ Business No. Employees

☐ Other


☐ Slab ☐ Crawl Space ☒ Basement w/plumbing ☐ Basement wo/plumbing

Water Supply: ☐ Individual ☐ Public ☒ Community


Comments:/Conditions:

Comments:/Conditions: Infiltrators installed

INITIAL SITE SKETCH

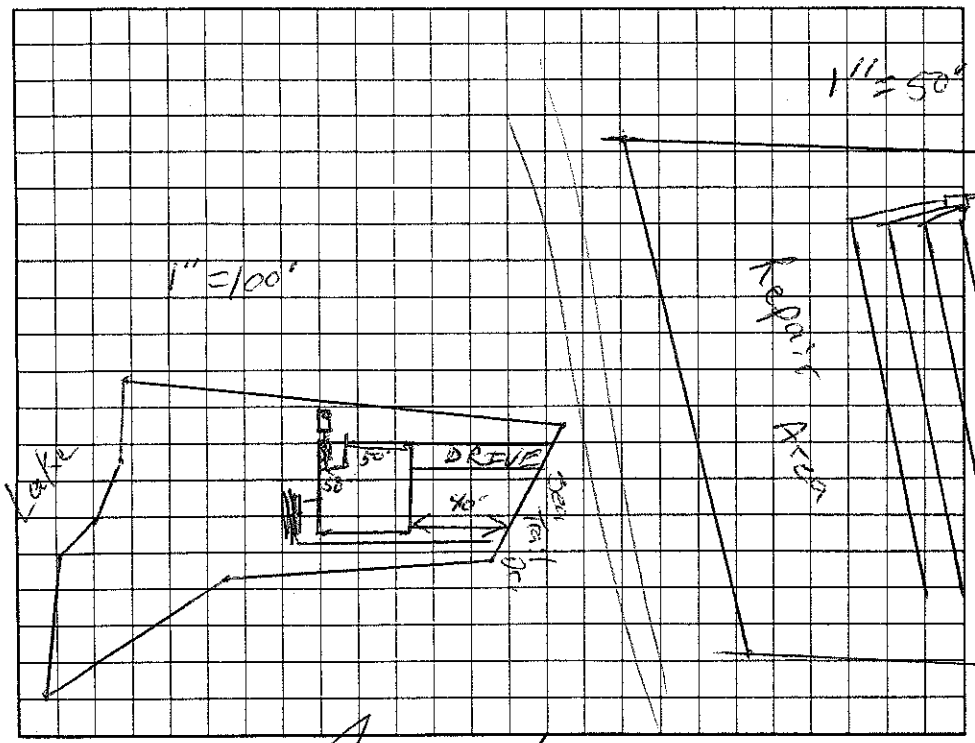

AS BUILT SKETCH

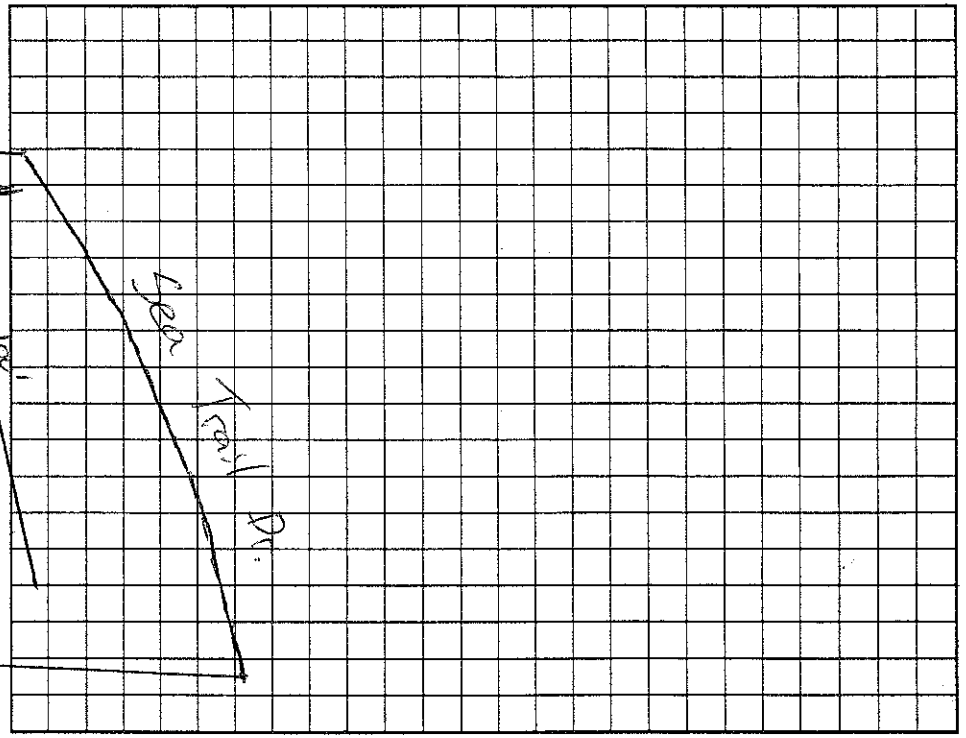

Permit can be suspended or revoked if any false information is supplied toward securing the permit/any unauthorized changes are made to the site/any unauthorized changes are made in the installation of the system. Improvement Permit with plat valid without expiration. Improvement Permit with site plan valid for sixty months. Authorization to Construct is valid for a period equal to that of Improvement Permit – not to exceed sixty months.

Signed: _____ date _____ Installed by: Rowan Septic / Paul Howard

Improvement Permit by: _____ RS date 2/25/04 Operation Permit by: Wesley Sparks RS. date 6/24/06

Authorization to Construct by: _____ RS date 2/25/04 Existing System Inspection by: _____ date _____

HEALTH DEPT. COPY: WHITE OWNER COPY (FINAL): YELLOW OWNER COPY (INITIAL): PINK