IREDELL COUNTY HEALTH DEPARTMENT

STATESVILLE 704-878-5305 MOORESVILLE 704-664-5281

IMPROVEMENT PERMIT / AUTHORIZATION TO CONSTRUCT / OPERATION PERMIT / EXISTING SYSTEM INSPECTION

(6130)

PERMIT# 079388 PIN# 4638 67 7862 DATE 2/24/99

OWNER OR CONTRACTOR Vasile Lazar PHONE: Business 924-7181 Home

ADDRESS c/o 281 Pilch Rd. Troutman, NC. 28166 - 152 SEA TRAIL DR

LOCATION North N TL Sea Trail Dr. on (R)

SUBDIVISION Harbor view BLOCK / SECTION 7 LOT 18 LOT AREA ~1.15 Ac SITE CLASS. PS DESIGN FLOW 480 L.T.A.R. .3

Septic Tank: 1000 Gallons; STB 825 Date

Pump Tank: 1000 Gallons; PT 19 Date

Pump Make: Hydro Watch Model SHBE050A1 Serial No. 5/99

Nitrification Field: No Fields 1 Square Feet 812 * Linear Feet 270 *

No Lines 3 Trench Width 36" Max Trench Bottom Depth 36" Gravel Depth SAND.

[X] New System [ ] Repair System Type: I, II, III, IV, V, VI

System Description: Pressure - 16" PPBS

Repair System Description: SAME

Maintenance Agreement Required: [ ] Yes [X] No

[X] House/Mod. Home No. Bedrooms 4

[ ] Mobile Home No. Bathrooms 3

[ ] Business No. Employees

[ ] Other


[ ] Slab [X] Crawl Space [ ] Basement w/plumbing [ ] Basement wo/plumbing

Water Supply: [ ] Individual [ ] Public [X] Community

Comments:/Conditions:

Comments:/Conditions:

INITIAL SITE SKETCH

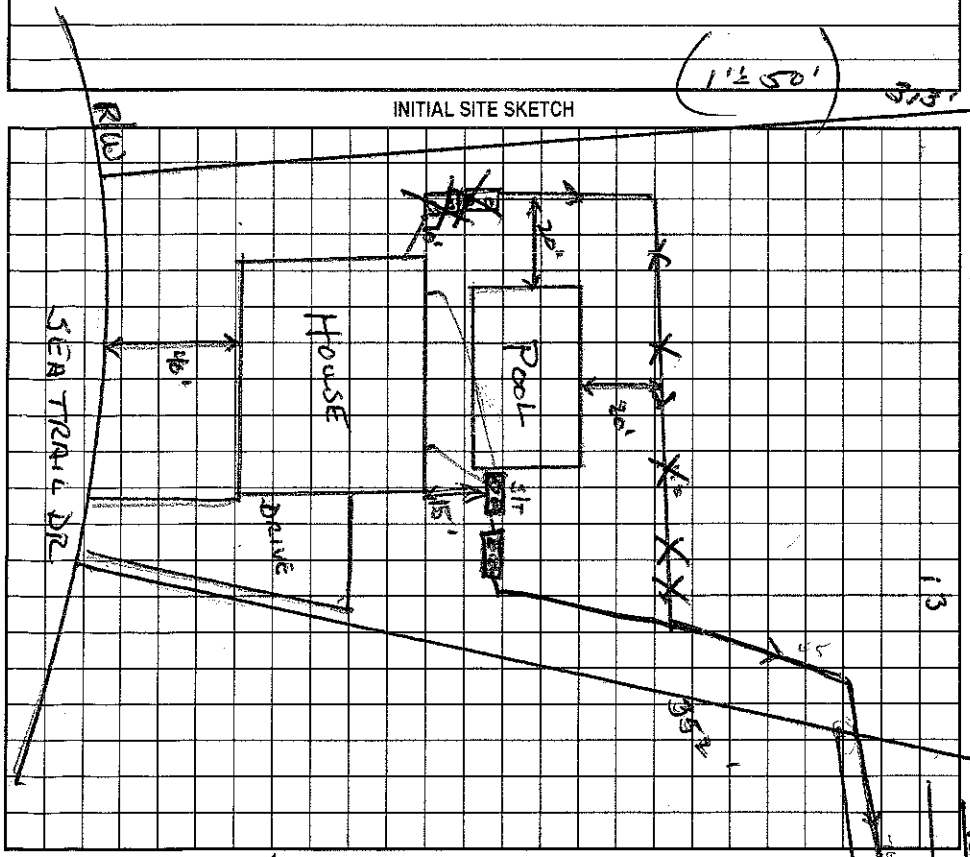

AS BUILT SKETCH

Permit can be suspended or revoked if any false information is supplied toward securing the permit/any unauthorized changes are made to the site/any unauthorized changes are made in the installation of the system. Improvement Permit with plat valid without expiration. Improvement Permit with site plan valid for sixty months. Authorization to Construct is valid for a period equal to that of Improvement Permit – not to exceed sixty months.

Signed: X Vasile Lazar 02.24.99 date Installed by: C&W Grading

Improvement Permit by: Wesley Sparks RS date 2/24/99 Operation Permit by: Wesley Sparks RS. date 7/8/99

Authorization to Construct by: Wesley Sparks RS. date 2/24/99 Existing System Inspection by: date

HEALTH DEPT. COPY: WHITE OWNER COPY (FINAL): YELLOW OWNER COPY (INITIAL): PINK