IREDELL COUNTY HEALTH DEPARTMENT

As Built

STATESVILLE 704-878-5305 MOORESVILLE 704-664-5281

IMPROVEMENT PERMIT / AUTHORIZATION TO CONSTRUCT / OPERATION PERMIT / EXISTING SYSTEM INSPECTION

PERMIT# 15650 PIN# 4638679310 DATE 4-25-05

OWNER OR CONTRACTOR Lawrence Lally PHONE: Business _____ Home _____

ADDRESS _____

LOCATION Perth Rd TL Sea Trail on left of Cul de Sac

SUBDIVISION Harborview BLOCK / SECTION 6 LOT 10 LOT AREA 1.74 Acre SITE CLASS PS DESIGN FLOW 450 gpd T.A.R. .3

Septic Tank: 1000 Gallons; STB 1012 Date 9-12-04

Pump Tank: _____ Gallons; PT _____ Date _____

Pump Make: _____ Model _____ Serial No. _____

Nitrification Field: No Fields 1 Square Feet 1260 Linear Feet 400

No Lines 5 Trench Width 36" Max Trench Bottom Depth 36" Gravel Depth N/A

☒ New System ☐ Repair System Type: I, II, III, IV, V, VI

System Description: Gravity 25% Reduction

Repair System Description: Panel Block

Maintenance Agreement Required: ☐ Yes ☒ No

☒ House/Mod. Home ☐ Mobile Home ☐ Business ☐ Other

No. Bedrooms 4 No. Bathrooms 2.5 No. Employees ____


☐ Slab ☐ Crawl Space ☒ Basement w/plumbing ☐ Basement wo/plumbing

Water Supply: ☐ Individual ☒ Public ☒ Community


Comments:/Conditions: * Plumbing stubbed out deep therefore ST moved downhill

Comments:/Conditions:

INITIAL SITE SKETCH Scale 1:50

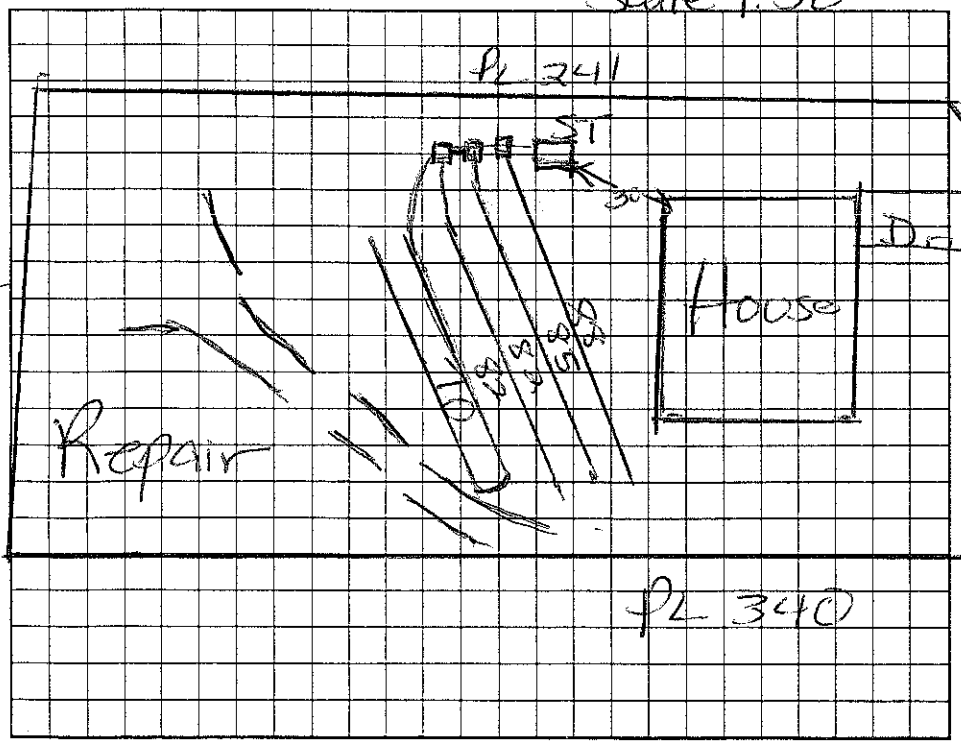

AS BUILT SKETCH

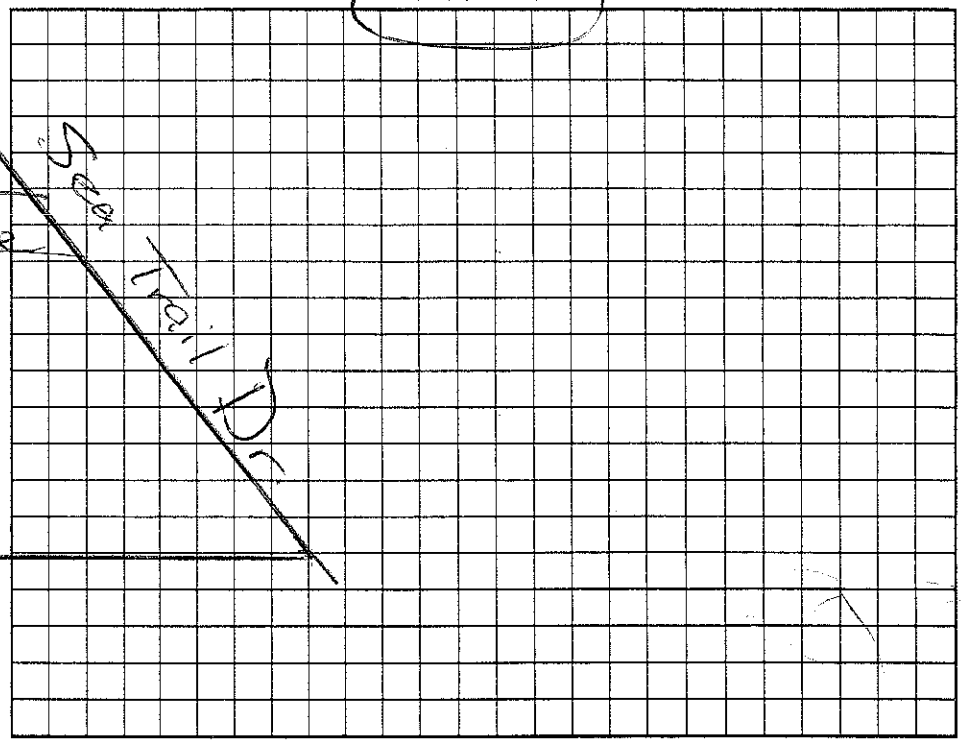

Permit can be suspended or revoked if any false information is supplied toward securing the permit/any unauthorized changes are made to the site/any unauthorized changes are made in the installation of the system. Improvement Permit with plat valid without expiration. Improvement Permit with site plan valid for sixty months. Authorization to Construct is valid for a period equal to that of Improvement Permit – not to exceed sixty months.

Signed: _____ date _____ Installed by: A-1 Backhoe RS

Improvement Permit by: _____ date _____ Operation Permit by: Maria H Dotson RS date 4/25/05

Authorization to Construct by: Maria H Dotson RS date 4/25/05 Existing System Inspection by: _____ date _____

HEALTH DEPT. COPY: WHITE OWNER COPY (FINAL): YELLOW OWNER COPY (INITIAL): PINK

IREDELL COUNTY HEALTH DEPARTMENT

STATESVILLE 704-878-5305 MOORESVILLE 704-664-5281

IMPROVEMENT PERMIT / AUTHORIZATION TO CONSTRUCT / OPERATION PERMIT / EXISTING SYSTEM INSPECTION

PERMIT# 115050 PIN# 4638679310 DATE 1-9-04

OWNER OR CONTRACTOR Lawrence Lally PHONE: Business _____ Home (704) 252-3011

ADDRESS 181 Stumpy Creek Mooresville, NC 28117

LOCATION Perth Rd To Sea Trail (just past Hideaway Ln) on left of Cul-de-Sac

SUBDIVISION Harbor View BLOCK / SECTION 6 LOT 10 LOT AREA 1.74 Acres SITE CLASS. PS DESIGN FLOW 480gpd L.T.A.R. .3

Septic Tank: 1000 Gallons; STB 1012 Date 9-12-04
Pump Tank: _____ Gallons; PT _____ Date _____
Pump Make: _____ Model _____ Serial No. _____
Nitrification Field: No Fields 1 Square Feet 1200 Linear Feet 400'
No Lines 6 Trench Width 36" Max Trench Bottom Depth 36" Gravel Depth N/A

[X] New System [ ] Repair System Type: I, II, (III), IV, V, VI
System Description: Gravity - 25% Reduction
Repair System Description: Pump/Gravity - Panel Block
Maintenance Agreement Required: [ ] Yes [X] No


[X] House/Mod. Home No. Bedrooms 4
[ ] Mobile Home No. Bathrooms 2.5
[ ] Business No. Employees ____
[ ] Other _____
[ ] Slab [ ] Crawl Space [X] Basement w/plumbing [ ] Basement wo/plumbing

Water Supply: [ ] Individual [X] Public [X] Community


Comments:/Conditions: Keep Septic System at least 10' From PL
Plumbing stubbed out deep, therefore ST moved down hill

Comments:/Conditions: Yellow filter installed

INITIAL SITE SKETCH Scale 1:50

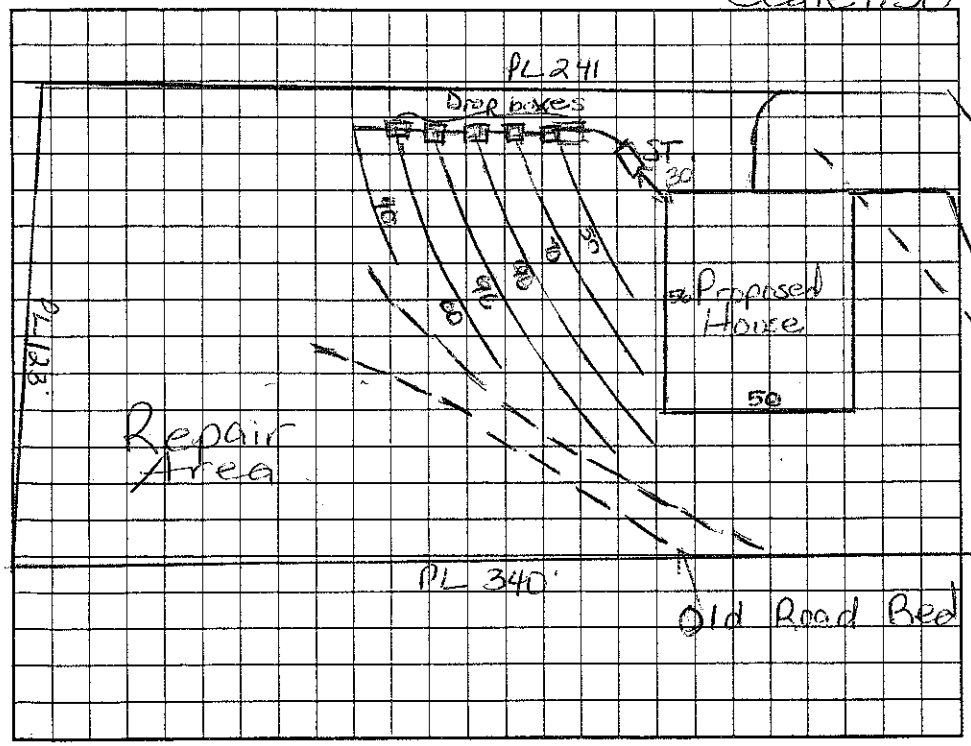

AS BUILT SKETCH

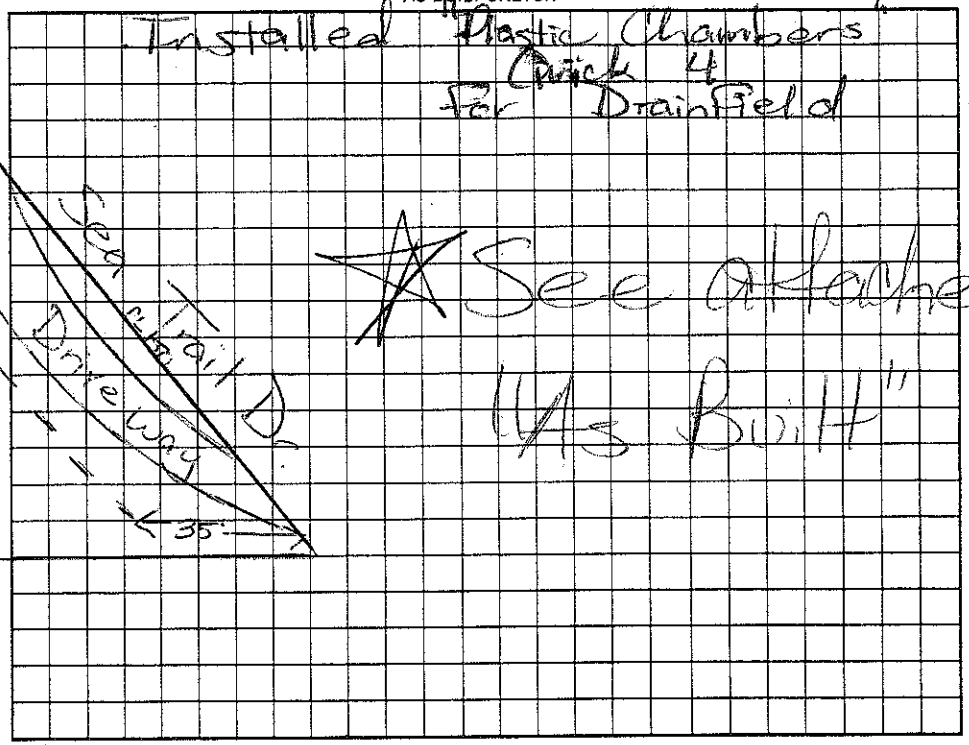

Permit can be suspended or revoked if any false information is supplied toward securing the permit/any unauthorized changes are made to the site/any unauthorized changes are made in the installation of the system. Improvement Permit with plat valid without expiration. Improvement Permit with site plan valid for sixty months. Authorization to Construct is valid for a period equal to that of Improvement Permit – not to exceed sixty months.

Signed: _____ date 12-1-04
Improvement Permit by: Maria H. Dobson RS date 1/9/04
Authorization to Construct by: Maria H. Dobson RS date 1/9/04

Installed by: A-1 Backhoe RS
Operation Permit by: Maria H. Dobson date 4/25/05
Existing System Inspection by: _____ date _____

HEALTH DEPT. COPY: WHITE OWNER COPY (FINAL): YELLOW OWNER COPY (INITIAL): PINK