IREDELL COUNTY HEALTH DEPARTMENT Const. Auth. STATESVILLE 704-878-5305 MOORESVILLE 704-664-5281

IMPROVEMENT PERMIT / ~~CERTIFICATE OF COMPLETION~~ / OPERATION PERMIT / EXISTING SYSTEM INSPECTION

PROPERTY DESCRIPTION NO. 23976 DATE Nov. 5, 96 TAX MAP NO. Part 25A80 Watershed: ☑ Yes ☐ No

OWNER OR CONTRACTOR Stumpy Creek LLC PHONE: Business 633-6124 ~~Home~~ 4638-68-0335

ADDRESS 614 N. Main Salisbury NC 28144

LOCATION Peeth Rd. N. TL Stumpy Creek Rd. TL Collingswood 4th Lot on left

SUBDIVISION Harborview BLOCK / SECTION III LOT 18 LOT AREA .57 SITE CLASS. PS per 1996 DESIGN FLOW ~~450~~ 360 gpd L.T.A.R. 2.3

Septic Tank: 1000 Gallons; STB 825 Date 4/1/97

Pump Tank: _____ Gallons; PT _____ Date _____

Pump Make: _____ Model _____ Serial No. _____

Nitrification Field: No Fields 1 Square Feet 1200 Linear Feet 400

No Lines 5@80' Trench Width 36" Max Trench Bottom Depth ~24" Gravel Depth NA

☑ New System ☐ Repair System Type: I II III IV V VI

System Description: gravity plastic ~~chambered~~

Repair System Description: ~~gravity pumped chambered~~

Maintenance Agreement Required: ☐ Yes ☑ No

☐ House/Mod. Home No. Bedrooms ~~4~~ 3

☐ Mobile Home No. Bathrooms 2½

☐ Business No. Employees ____

☐ Other _____

☑ Slab ☐ Crawl Space ☐ Basement w/plumbing ☐ Basement wo/plumbing


Water Supply:
☐ Individual
☑ Community
☐ Public

Comments:

Comments: TYPE II
CHANGED TO CONVENTIONAL SYSTEM - 3BR
C. [signature] 4/7/97

1"=50'

INITIAL SITE SKETCH

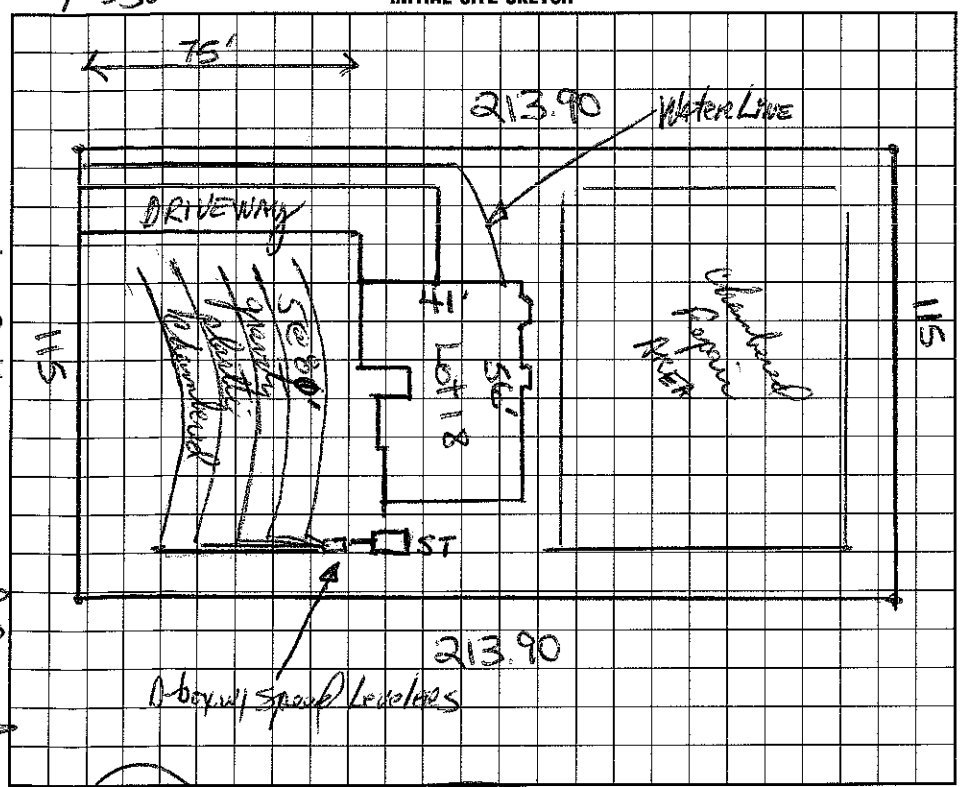

AS BUILT SKETCH

I understand that this permit can be suspended or revoked if any false information is supplied toward securing the permit/any unauthorized changes are made to the site/any unauthorized changes are made in the installation of the system.

Signed: _____ Installed by: DELBERT BOSTIAN

Improvement Permit by: [signature], RS date 11-5-96

Certificate of Completion by: _____ date _____

Existing System Inspection by: _____ date _____

Operation Permit by: C. [signature] date 11/6/97

Construction Authorization HEALTH DEPT. COPY: WHITE INSPECTION COPY (FINAL): GREEN OWNER COPY (FINAL): YELLOW INSPECTION COPY (INITIAL): PINK OWNER COPY (INITIAL): GOLD