IREDELL COUNTY HEALTH DEPARTMENT

Const Auth

STATESVILLE 704-878-5305 MOORESVILLE 704-664-5281

IMPROVEMENT PERMIT / ~~CERTIFICATE OF COMPLETION~~ / OPERATION PERMIT / EXISTING SYSTEM INSPECTION

PROPERTY DESCRIPTION NO. 066579 DATE Nov. 4, '97 TAX MAP NO. 4638-71-1167 (pt.)

OWNER OR CONTRACTOR Stumpy Creek LLC PHONE: Business 633-6124 Home 4638-68-1011

ADDRESS 614 N. Main St. Salisbury N.C. 28144 Watershed: ☑ Yes ☐ No

LOCATION Perth Rd. Turn on Stumpy Creek Rd. TL Kiskadee on Right

SUBDIVISION Hardscrabble BLOCK / SECTION 9 LOT 8 LOT AREA .6Ac SITE CLASS PS DESIGN FLOW 360gpd L.T.A.R. .03

Septic Tank: 1000 Gallons; STB 744 Date 5/18/98

Pump Tank: _____ Gallons; PT _____ Date _____

Pump Make: _____ Model _____ Serial No. _____

Nitrification Field: No Fields 1 Square Feet 1200 Linear Feet 400

No Lines 5@80' Trench Width 36" Max Trench Bottom Depth 24" Gravel Depth 12"

☑ New System ☐ Repair System Type: I, II, III, IV, V, VI

System Description: gravity conventional

Repair System Description: ~~new~~ pumped conventional

Maintenance Agreement Required: ☐ Yes ☑ No

☑ House/Mod. Home ☐ Mobile Home ☐ Business ☐ Other

No. Bedrooms 3 No. Bathrooms 2 No. Employees _____

☐ Slab ☑ Crawl Space ☐ Basement w/plumbing ☐ Basement wo/plumbing


Water Supply: ☐ Individual ☑ Community ☐ Public

Comments:


Comments:

1"=60'

INITIAL SITE SKETCH

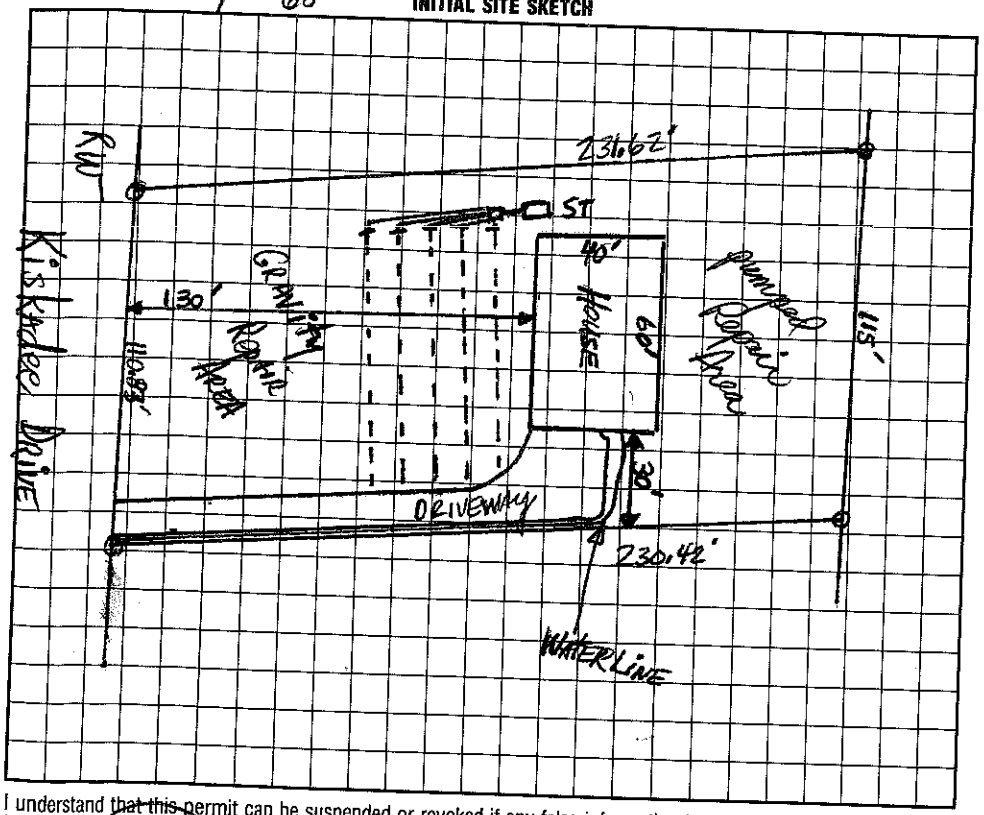

AS BUILT SKETCH

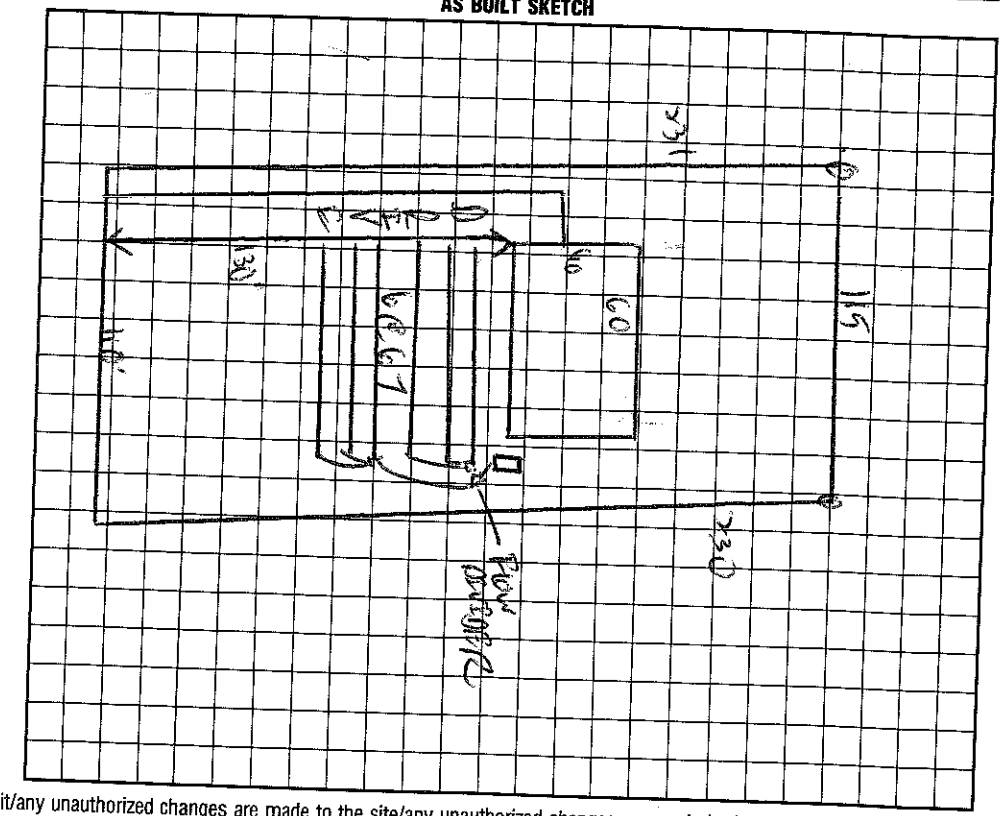

I understand that this permit can be suspended or revoked if any false information is supplied toward securing the permit/any unauthorized changes are made to the site/any unauthorized changes are made in the installation of the system. Improvement Permit is valid for 60 months from date of issuance.

Signed: _____

Improvement Permit by: _____ date 11-4-97

~~Existing System~~ Construction Authorization by: _____ date 11/4/98

Installed by: LARRY BEAM

Certificate of Completion by: _____ date _____

Operation Permit by: _____ date 8/18/98

HEALTH DEPT. COPY: WHITE INSPECTION COPY (FINAL): GREEN OWNER COPY (FINAL): YELLOW INSPECTION COPY (INITIAL): PINK OWNER COPY (INITIAL): GOLD