IREDELL COUNTY HEALTH DEPARTMENT Const. Auth. STATESVILLE 704-878-5305 MOORESVILLE 704-664-5281

IMPROVEMENT PERMIT / ~~CERTIFICATE OF COMPLETION~~ / OPERATION PERMIT / EXISTING SYSTEM INSPECTION

PROPERTY DESCRIPTION NO. 23978#5 DATE Nov. 5, '96 TAX MAP NO. Part of 25A80 Watershed: ☑ Yes ☐ No

OWNER OR CONTRACTOR Stumpy Creek LLC PHONE: Business 633-6124 ~~Home~~ 638-68-1414

ADDRESS 614 N. Main Salisbury NC 28144

LOCATION Perth Rd. N. TL Stumpy Creek Rd. TL Collingswood 3rd on Left

SUBDIVISION Harborview BLOCK / SECTION III LOT 17 LOT AREA .57 SITE CLASS. PS per 1996 DESIGN FLOW ~~440~~ 360 gpd L.T.A.R. n. 3

Septic Tank: 1000 Gallons; STB 825 Date 5/11/98

Pump Tank: _____ Gallons; PT _____ Date _____

Pump Make: _____ Model _____ Serial No. _____

Nitrification Field: No Fields 1 Square Feet 1200 Linear Feet 400

No Lines 5@80' Trench Width 36" Max Trench Bottom Depth ~24" Gravel Depth NA

☑ New System ☐ Repair System Type: I ☐ II ☐ III ☐ IV, V, VI Conv.

System Description: ~~gravity chamber bed~~ V

Repair System Description: ~~gravity pumped chamber bed~~

Maintenance Agreement Required? ☐ Yes ☑ No

☑ House/Mod. Home No. Bedrooms ~~3~~ 4

☐ Mobile Home No. Bathrooms 2½

☐ Business No. Employees ____

☐ Other _____

☑ Slab ☐ Crawl Space ☐ Basement w/plumbing ☐ Basement wo/plumbing

Water Supply: ☐ Individual ☑ Community ☐ Public

Comments:

1

Comments:

TYPE II


CHANGED TO CONVENTIONAL SYSTEM

3BR. Bath Fromm - 4/7/97

DRIVE MOVED OVER - 6 @ 67' INSTALLED.

1" = 50'

INITIAL SITE SKETCH

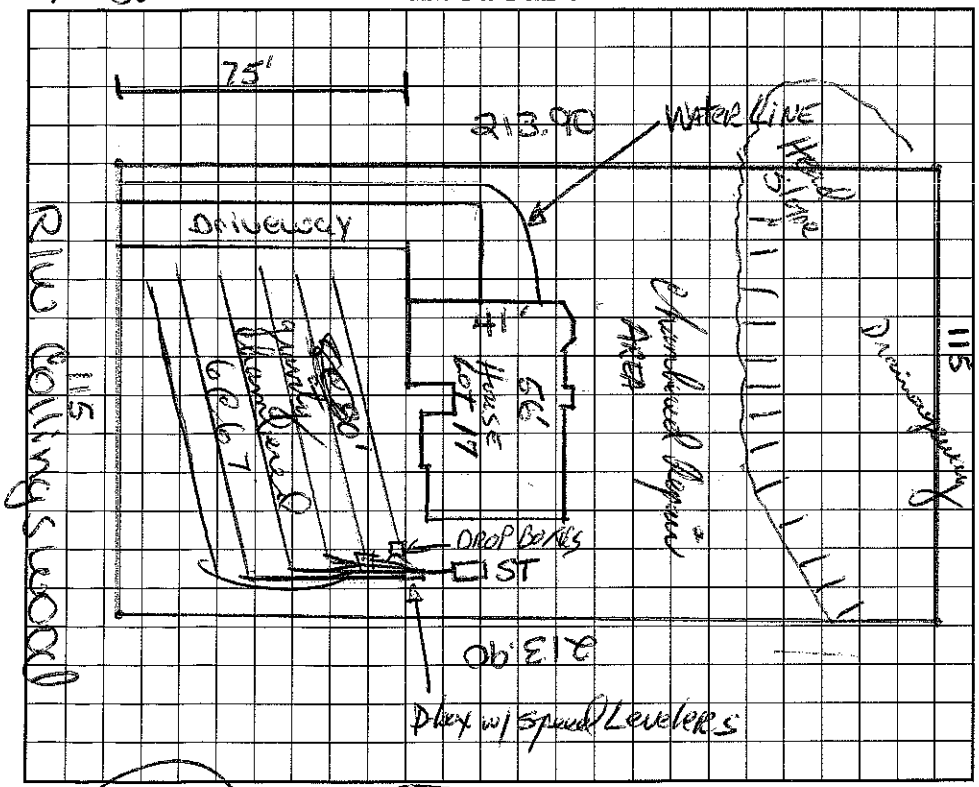

AS BUILT SKETCH

I understand that this permit can be suspended or revoked if any false information is supplied toward securing the permit/any unauthorized changes are made to the site/any unauthorized changes are made in the installation of the system.

Signed: _____

Improvement Permit by: _____ RS date 11-5-96

~~Existing System Inspection by:~~ Construction Authorization _____ date 4/7/97

Installed by: DELBERT BOSTIAN

Certificate of Completion by: _____ date _____

Operation Permit by: _____ RS date 7/9/98

HEALTH DEPT. COPY: WHITE INSPECTION COPY (FINAL): GREEN OWNER COPY (FINAL): YELLOW INSPECTION COPY (INITIAL): PINK OWNER COPY (INITIAL): GOLD