3:00

IREDELL COUNTY HEALTH DEPARTMENT Const. Auth. - STATESVILLE 704-878-5305 MOORESVILLE 704-664-5281

IMPROVEMENT PERMIT / ~~CERTIFICATE OF COMPLETION~~ / OPERATION PERMIT / EXISTING SYSTEM INSPECTION

PROPERTY DESCRIPTION NO. 23974 DATE Nov. 4, '96 TAX MAP NO. part of 25A80

OWNER OR CONTRACTOR Stumpy Creek LLC PHONE: Business 633-6124 ~~Home~~ 463-68-1573 Watershed: ☑ Yes ☐ No

ADDRESS 614 N. Main, Statesville NC 28144

LOCATION Poth Rd. N. TL Stumpy Creek Rd. TL Collingswood 2nd lot on left 350 MD

SUBDIVISION Harbor View BLOCK / SECTION III LOT 16 LOT AREA ±.57Ac SITE CLASS. PSpan.1452 DESIGN FLOW ~~460~~ gpd L.T.A.R. ~.3

Septic Tank: 1000 Gallons; STB 825 Date 4/3/97

Pump Tank: _____ Gallons; PT _____ Date _____

Pump Make: _____ Model _____ Serial No. _____

Nitrification Field: No Fields 1 Square Feet ~~1200~~ 900 Linear Feet ~~400~~ 300

No Lines 5@80' Trench Width 36" Max Trench Bottom Depth ~24" Gravel Depth NA

☑ New System ☐ Repair System Type: I, II, III, IV, V, VI

System Description: plastic chambered

Repair System Description: same or equal block

Maintenance Agreement Required: ☐ Yes ☑ No

☑ House/Mod. Home No. Bedrooms 3-4

☐ Mobile Home No. Bathrooms 2½

☐ Business No. Employees _____

☐ Other _____


☑ Slab ☐ Crawl Space ☐ Basement w/plumbing ☐ Basement wo/plumbing

Water Supply: ☐ Individual ☑ Community ☐ Public


Comments:

Comments: CHANGE TO 3BR

1"=50' **INITIAL SITE SKETCH** 5-60's

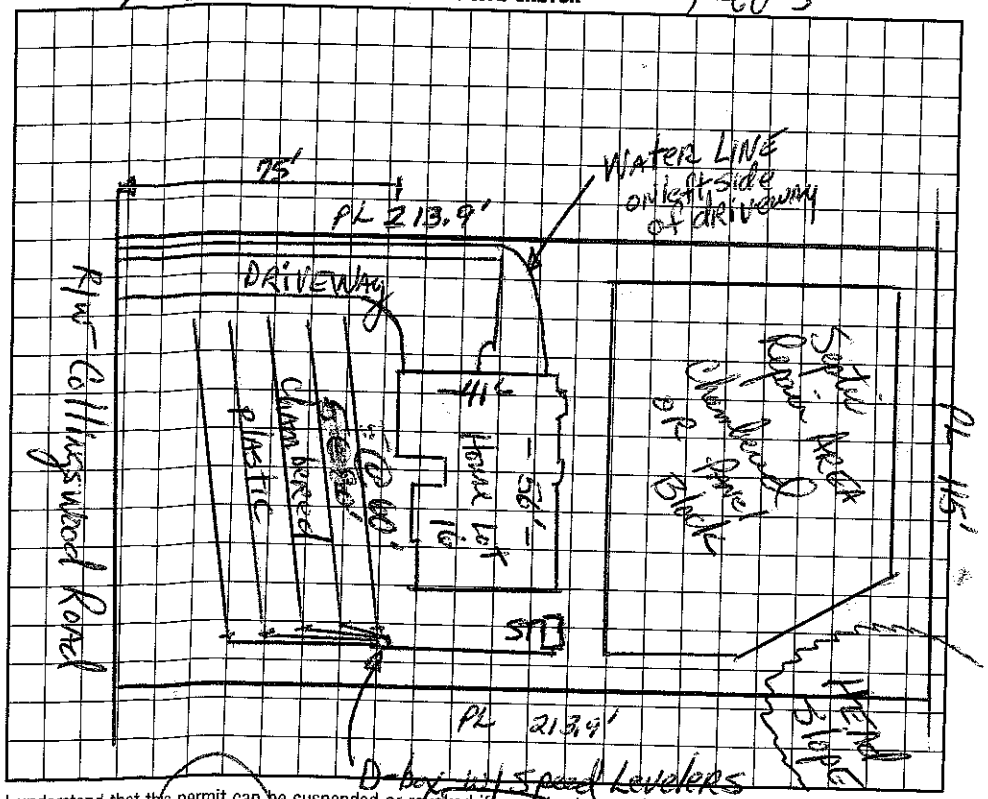

AS BUILT SKETCH

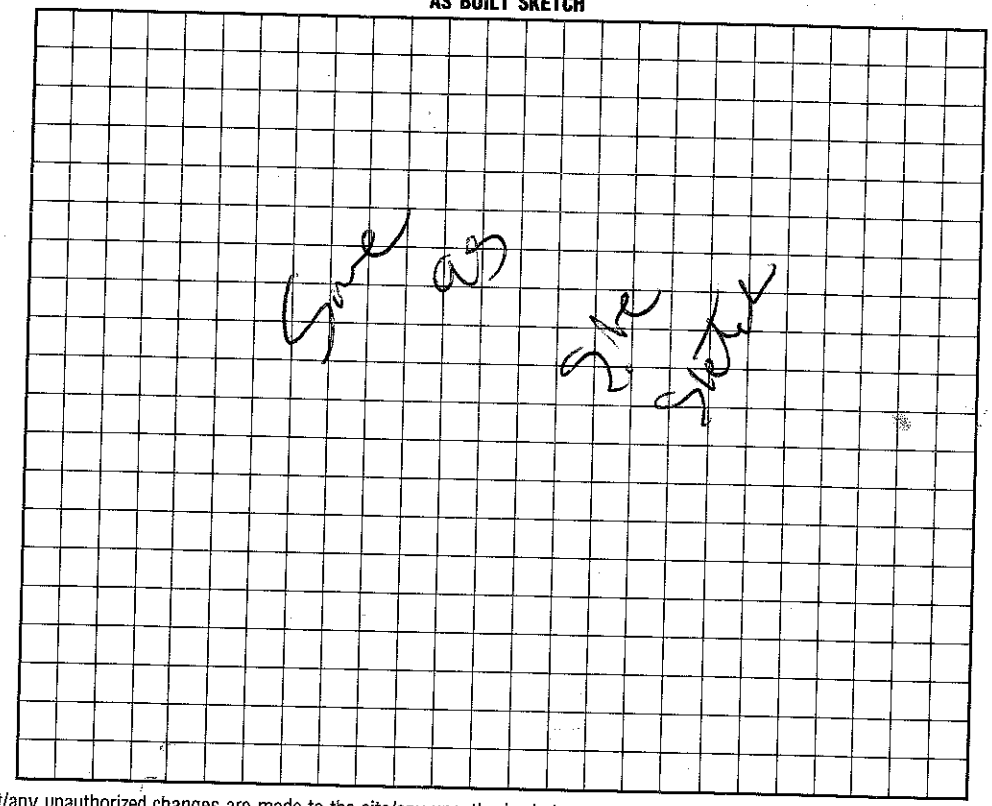

I understand that this permit can be suspended or revoked if any false information is supplied toward securing the permit/any unauthorized changes are made to the site/any unauthorized changes are made in the installation of the system.

Signed: X

Improvement Permit by: [signature] RS date 11-4-96

CONSTRUCTION AUTHORIZATION ~~Digging System Inspection by~~: [signature] RS date 11-6-96

Installed by: Rowan Septic

Certificate of Completion by: _____ date _____

Operation Permit by: [signature] date 5/30/97

HEALTH DEPT. COPY: WHITE INSPECTION COPY (FINAL): GREEN OWNER COPY (FINAL): YELLOW INSPECTION COPY (INITIAL): PINK OWNER COPY (INITIAL): GOLD