IREDELL COUNTY HEALTH DEPARTMENT

STATESVILLE 704-878-5305 MOORESVILLE 704-664-5281

IMPROVEMENT PERMIT / AUTHORIZATION TO CONSTRUCT / OPERATION PERMIT / EXISTING SYSTEM INSPECTION

PERMIT# 23973-116719 PIN# Part of 2514-80 Brian Mercer DATE 10/10/03

OWNER OR CONTRACTOR David Poston PHONE: Business 902-4038 Home 6082-8446 4638-68-2643

ADDRESS 116 Rosewood Ln Mooresville, NC 28117

LOCATION Perth Rd TL Stumpy Creek TL Collingswood 1st lot on left

SUBDIVISION Harborview BLOCK / SECTION 3 LOT 15 LOT AREA .6 Acre SITE CLASS PS DESIGN FLOW 480 L.T.A.R. .3

Septic Tank: 1000 Gallons; STB 1012 Date 9-2-03

Pump Tank: _____ Gallons; PT _____ Date _____

Pump Make: _____ Model 1200 Serial No. _____

Nitrification Field: No Fields 1 Square Feet 400' Linear Feet 400'

No Lines 3@133' Trench Width 36" Max Trench Bottom Depth 24-36" Gravel Depth N/A

☒ New System ☐ Repair System Type: I, II, (III), IV, V, VI

System Description: Gravity - 25% Reduction

Repair System Description: Pump/Grav Innovative

Maintenance Agreement Required: ☐ Yes ☒ No

☒ House/Mod. Home No. Bedrooms 4

☐ Mobile Home No. Bathrooms 3

☐ Business No. Employees ____

☐ Other _____


☐ Slab ☒ Crawl Space ☐ Basement w/plumbing ☐ Basement wo/plumbing

Water Supply: ☐ Individual ☒ Public ☒ Community

Comments/Conditions: Keep Septic System at least 10' From PL & 10' From house. Note: If Installer can not get lines long enough then install 4-100' lines.

Comments/Conditions:

INITIAL SITE SKETCH Scale 1:50

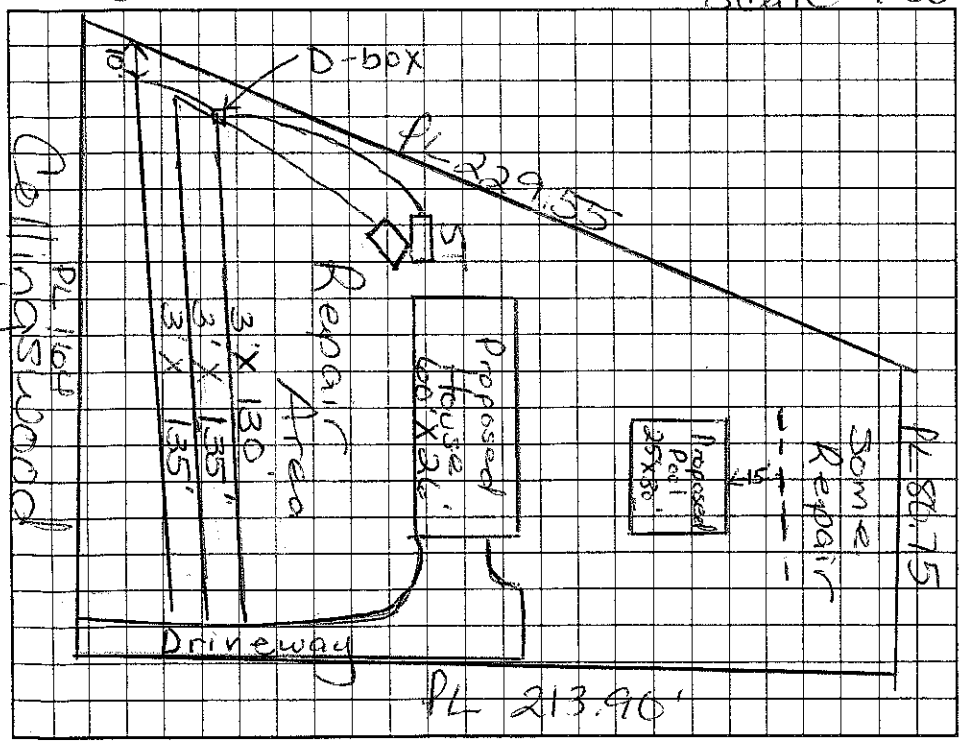

AS BUILT SKETCH

Drainlines Installed as Drawn

Used EZ Flow

Permit can be suspended or revoked if any false information is supplied toward securing the permit/any unauthorized changes are made to the site/any unauthorized changes are made in the installation of the system. Improvement Permit with plat valid without expiration. Improvement Permit with site plan valid for sixty months. Authorization to Construct is valid for a period equal to that of Improvement Permit – not to exceed sixty months.

Signed: Brian Mercer date 10/13/03 Installed by: A-1 Backhoe

Improvement Permit by: Maria H. Dotson R.S. date 10/10/03 Operation Permit by: Maria H. Dotson R.S. date 1/21/04

Authorization to Construct by: Maria H. Dotson R.S. date 10/13/03 Existing System Inspection by: _____ date _____

HEALTH DEPT. COPY: WHITE OWNER COPY (FINAL): YELLOW OWNER COPY (INITIAL): PINK