IREDELL COUNTY HEALTH DEPARTMENT

AUTHORIZATION TO CONSTRUCT

STATESVILLE 704-878-5305 MOORESVILLE 704-664-5281

2:30 pm

IMPROVEMENT PERMIT / CERTIFICATE OF COMPLETION / OPERATION PERMIT / EXISTING SYSTEM INSPECTION

PROPERTY DESCRIPTION NO. 23218 DATE 6/18/97 TAX MAP NO. 3S A 80 pt 4638771716 Watershed: ☑ Yes ☐ No

OWNER OR CONTRACTOR EAGLE WOOD BUILDERS PHONE: Business 4638-68-3668 Home 478-5151

ADDRESS 8649 BLUE HERON DR TERRELL NC 28682

LOCATION PERTH RD N- TL STUMPY CREEK ~.75 miles on Left

SUBDIVISION HARBORVIEW BLOCK / SECTION 2 LOT 17 LOT AREA .62 AC SITE CLASS. 1S DESIGN FLOW 360 GPD L.T.A.R. .3 GPD/FT2

Septic Tank: 1000 Gallons; STB 825 Date 9/16/97

Pump Tank: _____ Gallons; PT _____ Date _____

Pump Make: _____ Model _____ Serial No. _____

Nitrification Field: No Fields 1 Square Feet 900 Linear Feet 300

No Lines 4 @ 75' Trench Width 36" Max Trench Bottom Depth 36" Gravel Depth ASA

☑ New System ☐ Repair System Type: I, II, (III), IV, V, VI

System Description: GRAVITY CHAMBERED OR EQUIVALENT

Repair System Description: GRAV/PUMP CHAMBERED OR EQUIVALENT

Maintenance Agreement Required: ☐ Yes ☑ No

☑ House/Mod. Home No. Bedrooms 3

☐ Mobile Home No. Bathrooms 3

☐ Business No. Employees ____

☐ Other _____


☐ Slab ☑ Crawl Space ☐ Basement w/plumbing ☐ Basement wo/plumbing

Water Supply: ☐ Individual ☑ Community ☐ Public

Comments:

Comments:

INITIAL SITE SKETCH

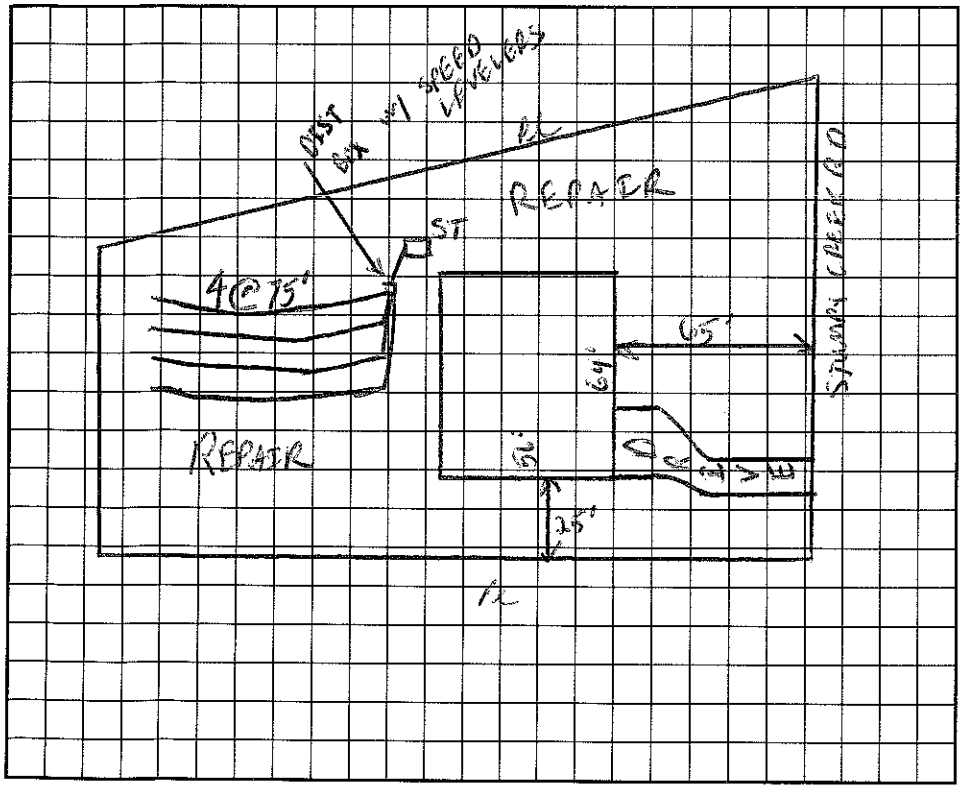

AS BUILT SKETCH

I understand that this permit can be suspended or revoked if any false information is supplied toward securing the permit/any unauthorized changes are made to the site/any unauthorized changes are made in the installation of the system. Improvement Permit is valid for 60 months from date of issuance.

Signed: _____

Improvement Permit by: _____ date 6/18/97

AUTHORIZATION TO CONSTRUCT

Existing System Inspection by: _____ date 6/18/97

Installed by: WAYNE CLONTZ

Certificate of Completion by: _____ date _____

Operation Permit by: _____ date 11/20/97

HEALTH DEPT. COPY: WHITE INSPECTION COPY (FINAL): GREEN OWNER COPY (FINAL): YELLOW INSPECTION COPY (INITIAL): PINK OWNER COPY (INITIAL): GOLD