IREDELL COUNTY HEALTH DEPARTMENT Const Auth STATESVILLE 704-878-5305 MOORESVILLE 704-664-5281

IMPROVEMENT PERMIT / ~~CERTIFICATE OF COMPLETION~~ / OPERATION PERMIT / EXISTING SYSTEM INSPECTION

PROPERTY DESCRIPTION NO. 066574 DATE Nov. 4, 97 TAX MAP NO. ~~4638771716 (pt.)~~ Watershed: ☑ Yes ☐ No

OWNER OR CONTRACTOR ~~Stumpy Creek LLC~~ (HARPER CONST.) PHONE: Business 4638-68-4446 Home WSIV CA

ADDRESS 614 N. Main St., Salisbury N.C. 28144

LOCATION Faith Rd. turn on Stumpy Creek Rd. TR Kiskadee on Right

SUBDIVISION Harborview BLOCK / SECTION 9 LOT 3 LOT AREA .68 Ac SITE CLASS. PS DESIGN FLOW 360 gpd L.T.A.R. .3

Septic Tank: 1000 Gallons; STB ____ Date ____

Pump Tank: 1000 Gallons; PT ____ Date ____

Pump Make: ____ Model ____ Serial No. ____

Nitrification Field: No Fields 1 Square Feet 1200 Linear Feet 400

No Lines 5@80' Trench Width 36" Max Trench Bottom Depth 24" Gravel Depth 12"

☑ New System ☐ Repair System Type: I, II, III, IV, V, VI

System Description: gravity conventional

Repair System Description: ~~gravity~~ pumped conventional

Maintenance Agreement Required: ☐ Yes ☑ No

☑ House/Mod. Home No. Bedrooms 3

☐ Mobile Home No. Bathrooms 2

☐ Business No. Employees ____

☐ Other ____

☐ Slab ☑ Crawl Space ☐ Basement w/plumbing ☐ Basement wo/plumbing


Water Supply: ☑ Individual ☑ Community ☐ Public

Comments:

Comments: Installed as drawn on Auth Const.

INITIAL SITE SKETCH

1" = 60'

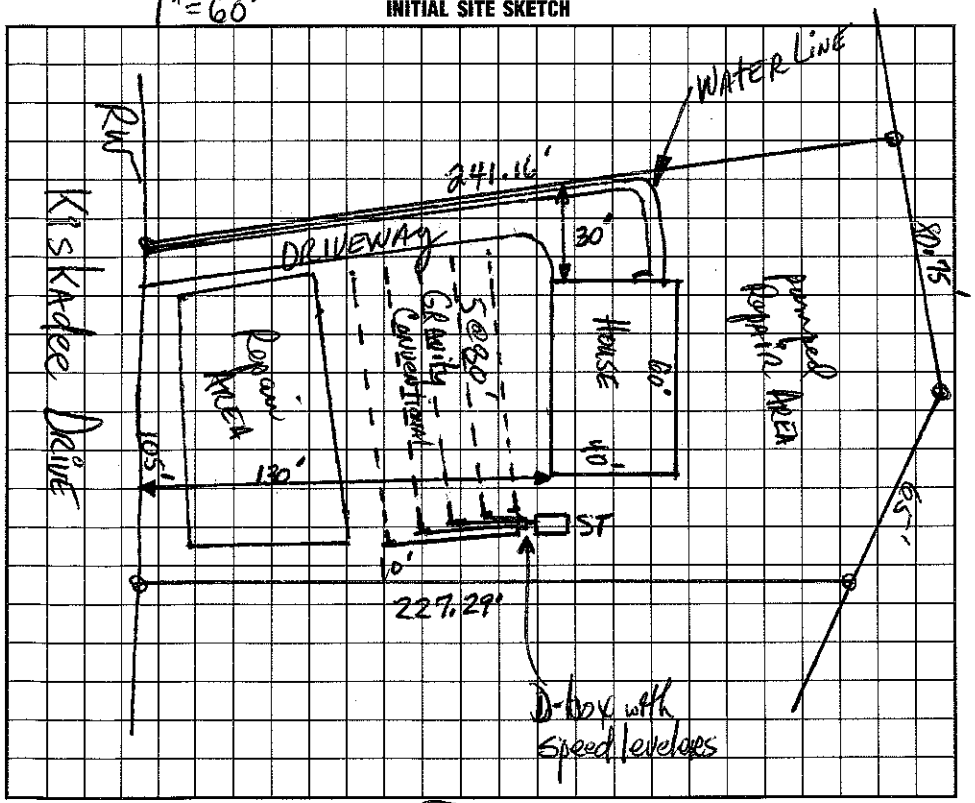

AS BUILT SKETCH

I understand that this permit can be suspended or revoked if any false information is supplied toward securing the permit/any unauthorized changes are made to the site/any unauthorized changes are made in the installation of the system. Improvement Permit is valid for 60 months from date of issuance.

Signed: ____

Improvement Permit by: D.R. Simson RS date 11-4-97

~~Construction Existing System Inspection by~~ Authorization: Wesley Sparks RS date 12/18/97

Installed by: Larry Beam

Certificate of Completion by: Wesley Sparks RS date 5/20/98

Operation Permit by: ____ date ____

HEALTH DEPT. COPY: WHITE INSPECTION COPY (FINAL): GREEN OWNER COPY (FINAL): YELLOW INSPECTION COPY (INITIAL): PINK OWNER COPY (INITIAL): GOLD