4658-68-4761

IREDELL COUNTY HEALTH DEPARTMENT

Const. Auth. STATESVILLE 704-878-5305 MOORESVILLE 704-664-5281

IMPROVEMENT PERMIT / ~~CERTIFICATE OF COMPLETION~~ / OPERATION PERMIT / EXISTING SYSTEM INSPEC. ON

PROPERTY DESCRIPTION NO. 23217 DATE April 3, '96 TAX MAP NO. part of 2580 Watershed: ☑ Yes ☐ No

OWNER OR CONTRACTOR Stumpy Creek LLC PHONE: Business 633-6124 Home

ADDRESS 614 N. Main / Salisbury NC 28144

LOCATION 150 W TR Perth Rd. / TL Stumpy Creek Rd. on left

SUBDIVISION Harborview BLOCK / SECTION II LOT 13 LOT AREA .58ac SITE CLASS. PS per 1956 DESIGN FLOW 480 gpd. L.T.A.R. .3

Septic Tank: 1000 Gallons; STB 325 Date 4/20/96

Pump Tank: Gallons; PT Date

Pump Make: Model Serial No.

Nitrification Field: No Fields 1 Square Feet 1200 Linear Feet 400

No Lines 4@100 Trench Width 36" Max Trench Bottom Depth ± 24" Gravel Depth N/A

☑ New System ☐ Repair System Type: I, II, (III), IV, V, VI

System Description: gravity chambered

Repair System Description: Low Pressured Chambered

Maintenance Agreement Required: ☐ Yes ☐ No

☑ House/Mod. Home ☐ Mobile Home ☐ Business ☐ Other

No. Bedrooms 4 No. Bathrooms 2½ No. Employees

☑ Slab ☐ Crawl Space ☐ Basement w/plumbing ☐ Basement wo/plumbing


Water Supply: ☐ Individual ☑ Community ☐ Public

Comments:

Comments:

1"=60'

INITIAL SITE SKETCH

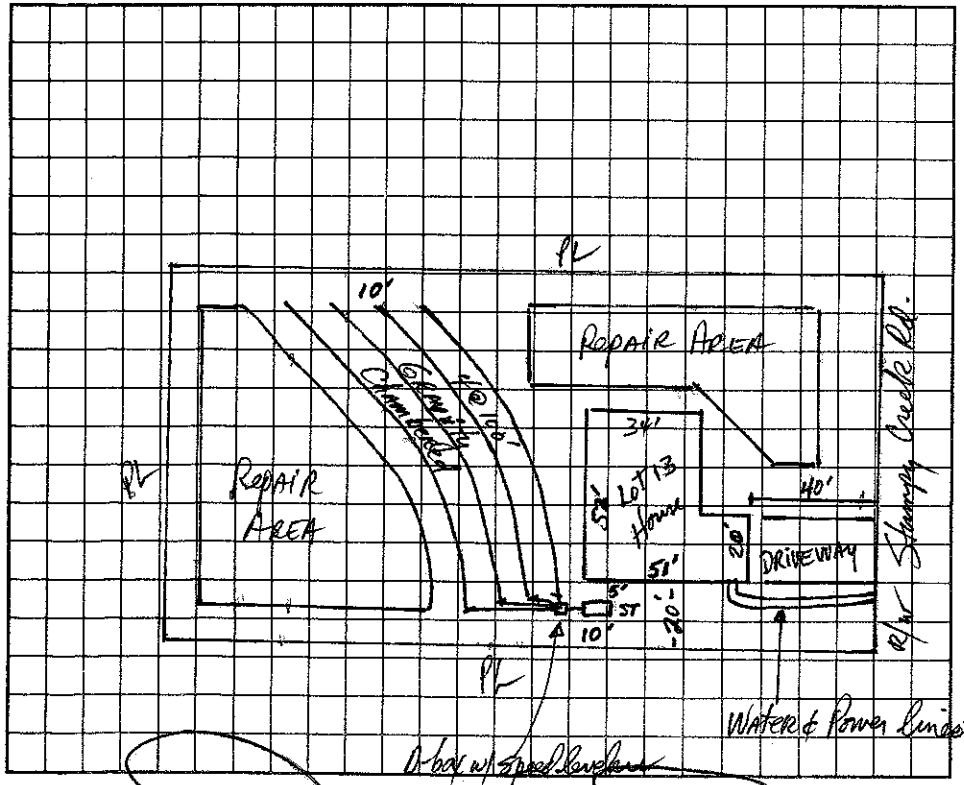

AS BUILT SKETCH

I understand that ~~this permit~~ can be suspended or revoked if any false information is supplied toward securing the permit/any unauthorized changes are made to the site/any unauthorized changes are made in the installation of the system.

Signed:

Improvement Permit by: David R. Hyman, RS date 4-3-96

~~Construction/Existing System Inspection by:~~ R Hyman RS date 7-2-96

Installed by: Rowan Septic Tank

Certificate of Completion by: date

Operation Permit by: Wesley Gibbons RS date 11-7-96

~~Authorized Representative~~

HEALTH DEPT. COPY: WHITE INSPECTION COPY (FINAL): GREEN OWNER COPY (FINAL): YELLOW INSPECTION COPY (INITIAL): PINK OWNER COPY (INITIAL): GOLD