IREDELL COUNTY HEALTH DEPARTMENT

STATESVILLE 704-878-5305 MOORESVILLE 704-664-5281

IMPROVEMENT PERMIT / AUTHORIZATION TO CONSTRUCT / OPERATION PERMIT / EXISTING SYSTEM INSPECTION

PERMIT # 1673160 PIN # 4638-68-5048 DATE 8-12-10

OWNER or APPLICANT JASON & CASEY SHERRILL PHONE: Business 704-506-5916 Home:

OWNER or APPLICANT ADDRESS 141 KISKADEE DR MOORESVILLE 28117

LOCATION / DIRECTIONS PERTH, STUMPY CREEK, KISKADEE, 141

SUBDIVISION HARBOR VIEW BLOCK / SECTION LOT # 21 LOT AREA .87 DESIGN FLOW 360 GPD L.T.A.R. .3

Septic Tank Ex. 1000 Gallons: STB Date

Pump Tank Gallons: PT Date

Pump Make Model Serial #

Nitrification Field No Fields 1 No Lines Linear Feet

Trench Width Max. Trench Bottom Depth 18" AVG Gravel Depth

☐ New System ☐ Repair ☐ Expansion System Type I (II) III IV V VI

System Description: GRAVITY GRAVEL

Repair System Description: SAME

Maintenance Agreement Required ☐ YES ☒ NO

☐ GRAVITY ☐ PRESSURE

☒ Residence No. Bedrooms 3

☐ Business No. Persons

☐ Other No. Employees

☐ Slab ☐ Crawl Space


☐ Basement w/plumbing ☒ Basement w/o plumbing

Water Supply: ☐ Private ☐ Public ☒ Community

Comments / Conditions: 1) ADDITION MUST BE 5' FROM ANY PART OF SEPTIC SYSTEM 2) SYSTEM LOOKS GOOD @ TIME OF INSPECTION


Comments / Conditions

INITIAL SITE SKETCH

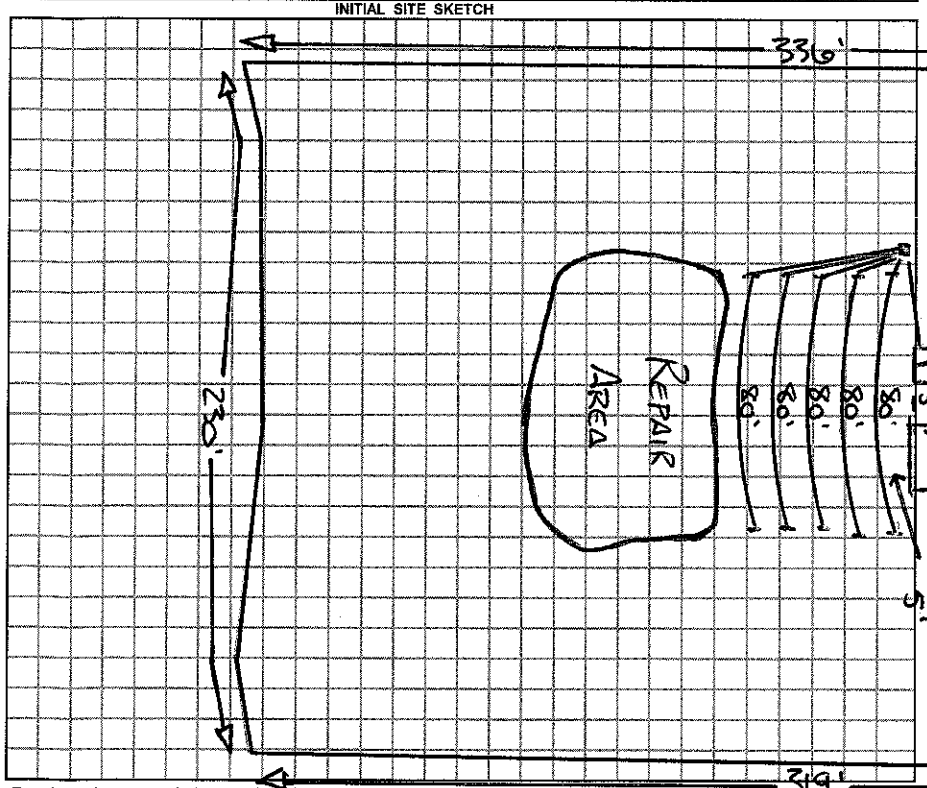

AS BUILT SKETCH

1"=60'

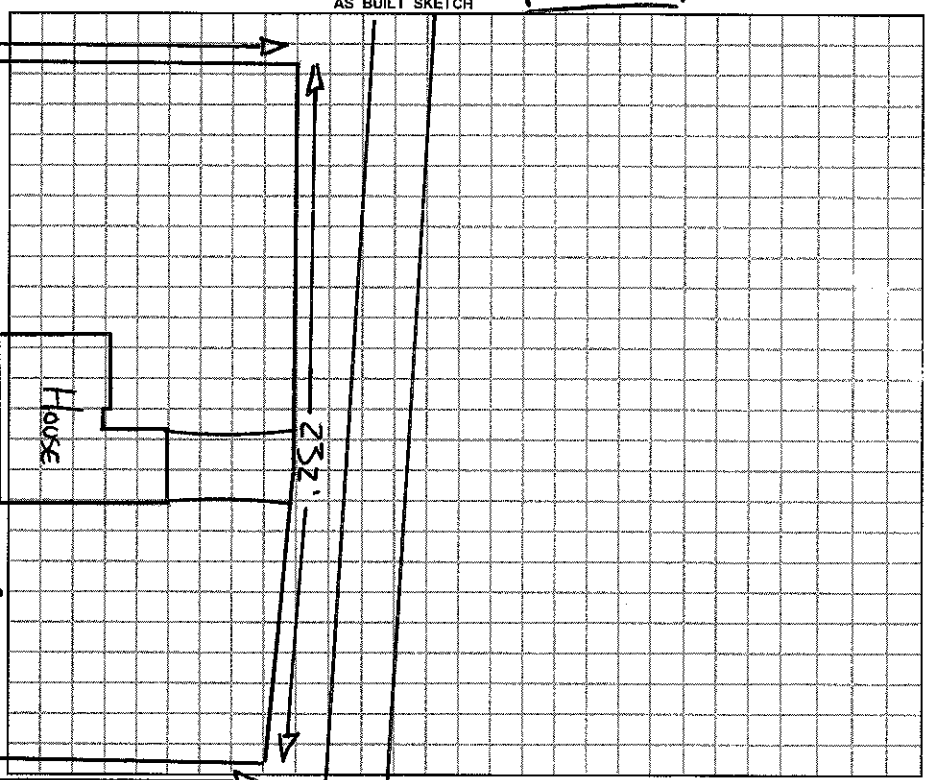

Permit can be suspended or revoked if any false information is supplied toward securing the permit / any unauthorized changes are made to the site / any unauthorized changes are made in the installation of the system.

☐ *IMPROVEMENT PERMIT w / plat valid without expiration.* ☒ *IMPROVEMENT PERMIT w / site plan valid for 60 mos.* ☐ *AUTHORIZATION TO CONSTRUCT valid for period equal to IMPROVEMENT PERMIT-not to exceed 60 mo.*

Owner / Applicant Signature: Casey L. Sherrill Date 8/12/10

Improvement Permit by: Date

Authorization to Construct by: Date

YOU SHOULD CONTACT A LOCATOR SERVICE PRIOR TO ANY EXCAVATION.

Installed by:

Operation Permit by: Date:

Existing System Inspected by: REHS Date: 8-12-10

WHITE COPY Environmental Health YELLOW COPY (Final) Owner / Applicant PINK COPY (Initial) Owner / Applicant