IREDELL COUNTY HEALTH DEPARTMENT

STATESVILLE 704-878-5305 MOORESVILLE 704-664-5281

IMPROVEMENT PERMIT / AUTHORIZATION TO CONSTRUCT / OPERATION PERMIT / EXISTING SYSTEM INSPECTION

PERMIT# 066591 PIN# 4638771716 (pt) 4638-68-5048 / 4638-68-6107 DATE Dec. 29, 97

OWNER OR CONTRACTOR Stumpy Creek LLC PHONE: Business 633-6124 Home

ADDRESS 614 N. Main St. Salisbury N.C. 28144

LOCATION Perth Rd. N. TL Stumpy Creek TL Kiskadee on left

SUBDIVISION Harborview BLOCK / SECTION 9 LOT 21+22 Combined LOT AREA 1.72 ac SITE CLASS. B DESIGN FLOW 480gpd L.T.A.R. .33

Septic Tank: 1000 Gallons; STB 823 Date 8/3/98

Pump Tank: Gallons; PT Date

Pump Make: Model Serial No.

Nitrification Field: No Fields 1 Square Feet 1200 Linear Feet 400

No Lines 5@80' Trench Width 36" Max Trench Bottom Depth 24" Gravel Depth NA

☑ New System ☐ Repair System Type: I, II, III, IV, V, VI

System Description: gravity modified 25% Reduction

Repair System Description: SAME

Maintenance Agreement Required: ☐ Yes ☑ No

☑ House/Mod. Home No. Bedrooms 4

☐ Mobile Home No. Bathrooms 3

☐ Business No. Employees

☐ Other


☐ Slab ☑ Crawl Space ☐ Basement w/plumbing ☐ Basement wo/plumbing

Water ☐ Individual ☐ Public ☑ Community


Comments:/Conditions:

Comments:/Conditions: (CHANGED TO CONVENTIONAL CBF) (ONLY 3BR HOUSE)

INITIAL SITE SKETCH

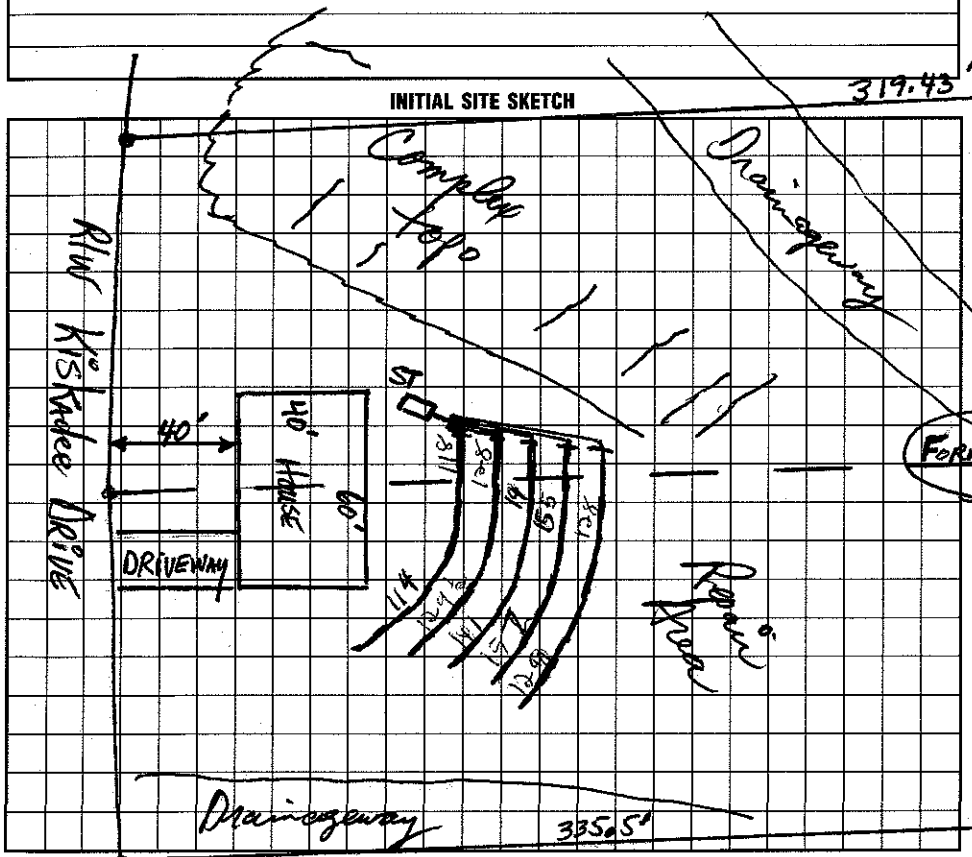

AS BUILT SKETCH

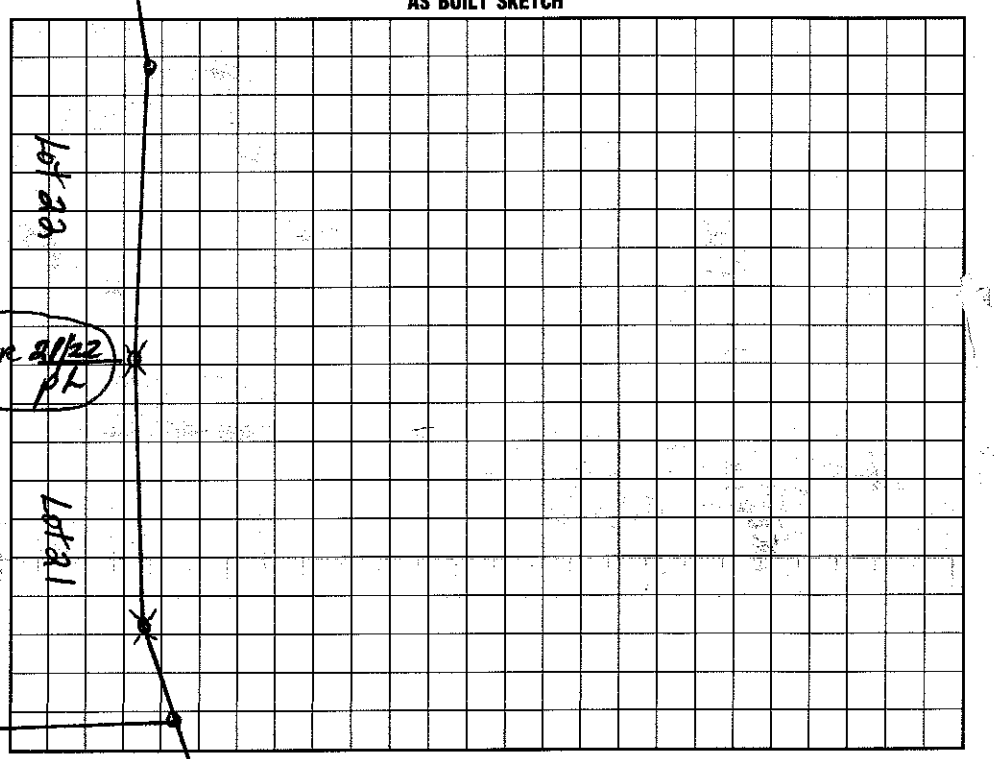

I understand that this permit can be suspended or revoked if any false information is supplied toward securing the permit/any unauthorized changes are made to the site/any unauthorized changes are made in the installation of the system. Improvement Permit with plat valid without expiration. Improvement Permit with site plan valid for sixty months. Authorization to Construct is valid for a period equal to that of Improvement Permit – not to exceed sixty months.

Signed: date

Improvement Permit by: date 12-29-97

Authorization to Construct by: date 5-19-98

Installed by: ROWAN SEPTIC

Operation Permit by: date 10/1/98

Existing System Inspection by: date

HEALTH DEPT. COPY: WHITE INSPECTION COPY (FINAL): GREEN OWNER COPY (FINAL): YELLOW INSPECTION COPY (INITIAL): PINK OWNER COPY (INITIAL): GOLD