3,80

IREDELL COUNTY HEALTH DEPARTMENT

STATESVILLE 704-878-5305 MOORESVILLE 704-664-5281

IMPROVEMENT PERMIT / AUTHORIZATION TO CONSTRUCT / OPERATION PERMIT / EXISTING SYSTEM INSPECTION

PERMIT# 066594 PIN# ~~4638771746 (pt)~~ 4638-68-6285 DATE Jan. 5, 98

OWNER OR CONTRACTOR Stumpy Creek LLC PHONE: Business 633-6124 Home

ADDRESS 614 N. Main Salisbury N.C. 28144

LOCATION Poth Rd N. TL Stumpy Creek TL Kiskadee on left

SUBDIVISION Hankourieur BLOCK / SECTION 9 LOT 23/24 COMBINED LOT AREA 1.6 Ac SITE CLASS. PS DESIGN FLOW 360 gpd L.T.A.R. ~ .3

Septic Tank: 1000 Gallons; STB 825 Date 1/12/98

Pump Tank: Gallons; PT Date

Pump Make: Model Serial No.

Nitrification Field: No Fields 1 Square Feet 900 Linear Feet 300

No Lines 4@75' Trench Width 36" Max Trench Bottom Depth 36"

☑ New System ☐ Repair System Type: I, II, III, IV, V, VI

System Description: Gravity Modified 25% Reduction

Repair System Description: SAME

Maintenance Agreement Required: ☐ Yes ☑ No

Gravel Depth N/A

☑ House/Mod. Home No. Bedrooms 3

☐ Mobile Home No. Bathrooms 2

☐ Business No. Employees

☐ Other

☐ Slab ☑ Crawl Space ☐ Basement w/plumbing ☐ Basement wo/plumbing

Water Supply: ☐ Individual ☐ Public ☑ Community

Comments:/Conditions:


* ONE INSPECTION / OBSERVATION PORT PER LATERAL

Comments:/Conditions:


3 @ 100' INSTALLED INSTEAD OF 4 @ 75'

1" = 60'

INITIAL SITE SKETCH

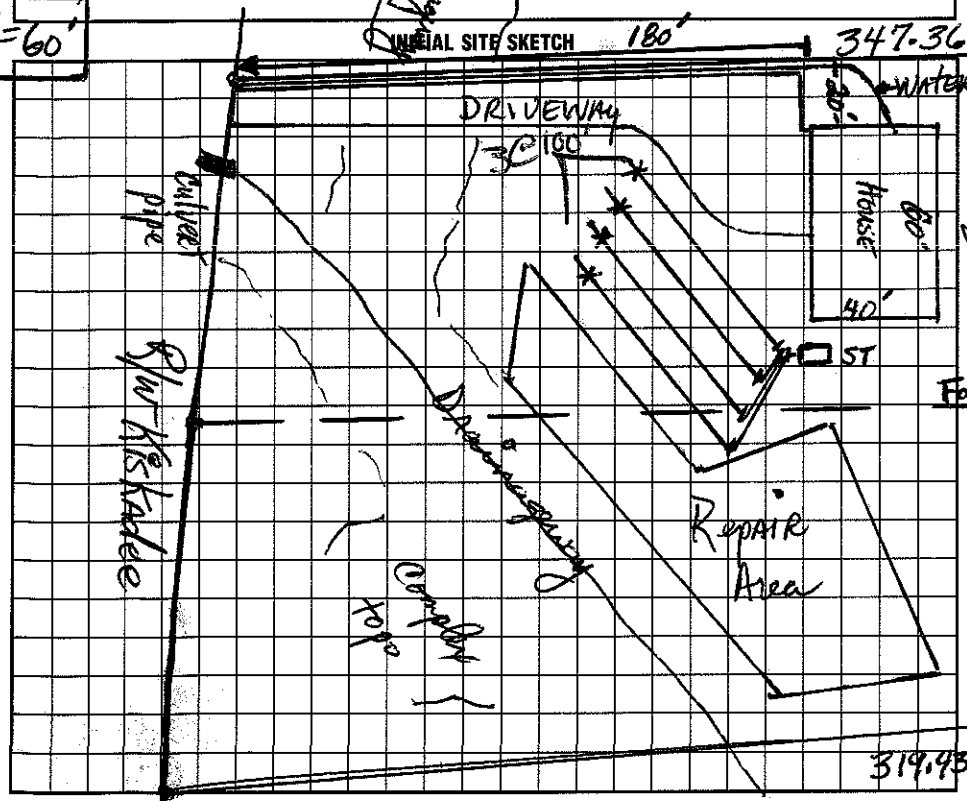

AS BUILT SKETCH

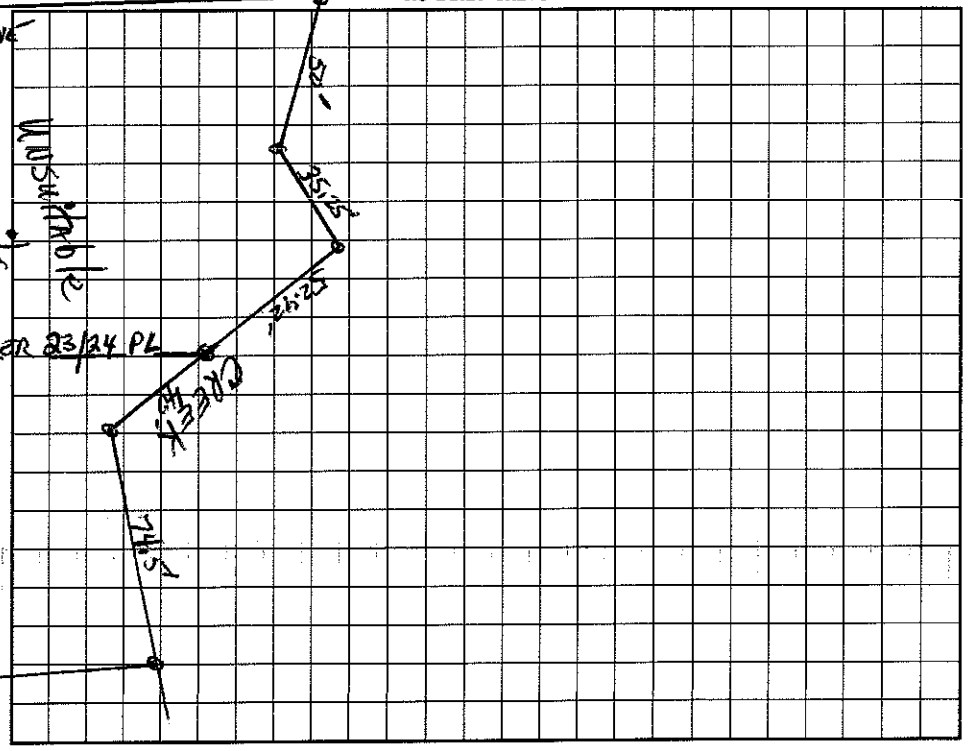

I understand that this permit can be suspended or revoked if any false information is supplied toward securing the permit/any unauthorized changes are made to the site/any unauthorized changes are made in the installation of the system. Improvement Permit with plat valid without expiration. Improvement Permit with site plan valid for sixty months. Authorization to Construct is valid for a period equal to that of Improvement Permit – not to exceed sixty months.

Signed: date

Improvement Permit by: date 1-5-98

Authorization to Construct by: date 7/1/98

Installed by: ROWAN SEPTIC

Operation Permit by: date 1/12/99

Existing System Inspection by: date

HEALTH DEPT. COPY: WHITE INSPECTION COPY (FINAL): GREEN OWNER COPY (FINAL): YELLOW INSPECTION COPY (INITIAL): PINK OWNER COPY (INITIAL): GOLD