230

IREDELL COUNTY HEALTH DEPARTMENT

STATESVILLE 704-878-5305 50.00 Paid 93040 MOORESVILLE 704-664-5281

IMPROVEMENT PERMIT / AUTHORIZATION TO CONSTRUCT / OPERATION PERMIT / EXISTING SYSTEM INSPECTION

PERMIT# 109 809 PIN# 4638-68-5563 4638-68-6508 DATE 10/31/02

OWNER OR CONTRACTOR Rick Otto PHONE: Business 769-528-8282 Home

ADDRESS 812 Trace Ct. Troutman NC 28166

LOCATION Perth TL Stumpy Crk, TL Kiskadee on Rt.

SUBDIVISION Harborview BLOCK / SECTION 9 LOT 1+2 LOT AREA 1.12 AC SITE CLASS. RS DESIGN FLOW 480 L.T.A.R. 0.3

Septic Tank: 1000 Gallons: STB 600 Date 6/11/03
Pump Tank: 1000 Gallons: PT 374 Date 4/17/03
Pump Make: Zoeller Model N 152 A Serial No.
Nitrification Field: No Fields 1 Square Feet 1200 Linear Feet 400
No Lines 4 @ 100' Trench Width 36" Max Trench Bottom Depth 24" Gravel Depth —

☒ New System ☐ Repair System Type: I, II, III, IV, V, VI
System Description: Press. Man. 25% Red. LP Panel
Repair System Description: ~~Sand~~
Maintenance Agreement Required: ☐ Yes ☒ No Block


☒ House/Mod. Home No. Bedrooms 4
☐ Mobile Home No. Bathrooms 2½
☐ Business No. Employees
☐ Other

☐ Slab ☒ Crawl Space ☐ Basement w/plumbing ☐ Basement wo/plumbing

Water Supply: ☐ Individual ☐ Public ☒ Community


Comments/Conditions: Property was severely modified After Initial Inspection. Much of the Repair Area was benched out making it unsuitable. LP Panel block will be required for Repair

INITIAL SITE SKETCH 1" = 60'

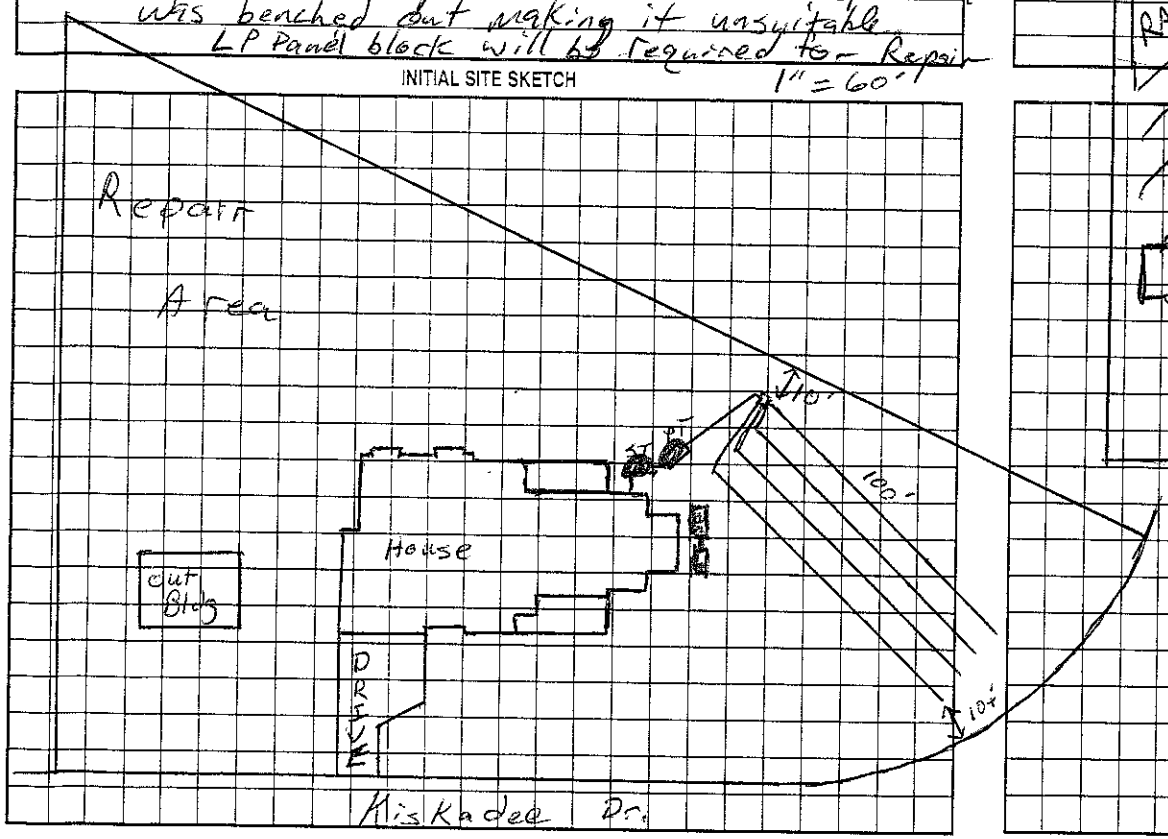

Comments/Conditions: Bio Diffusion Sand Mound - 6 @ 67 Checked pressure, elect. & alarm 9/2/03

AS BUILT SKETCH NOT to Scale

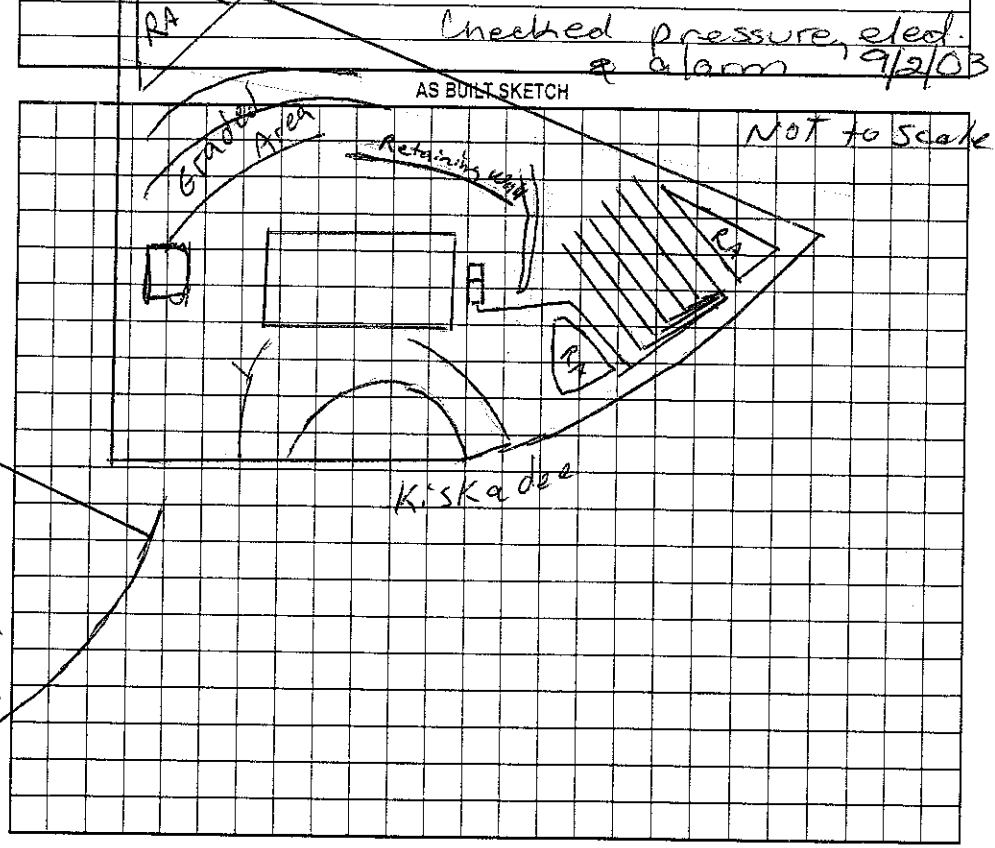

Permit can be suspended or revoked if any false information is supplied toward securing the permit/any unauthorized changes are made to the site/any unauthorized changes are made in the installation of the system. Improvement Permit with plat valid without expiration. Improvement Permit with site plan valid for sixty months. Authorization to Construct is valid for a period equal to that of Improvement Permit – not to exceed sixty months.

Signed: RO Bowe date 11-04-02

Improvement Permit by: RS date 10/31/02

Authorization to Construct by: RS date 10/31/02

Installed by: Wayne Conte

Operation Permit by: Maina H H Dotson RS date 9/2/03

Existing System Inspection by: date

HEALTH DEPT. COPY: WHITE OWNER COPY (FINAL): YELLOW OWNER COPY (INITIAL): PINK