1:00

IREDELL COUNTY HEALTH DEPARTMENT

STATESVILLE 704-878-5305 MOORESVILLE 704-664-5281

IMPROVEMENT PERMIT / AUTHORIZATION TO CONSTRUCT / OPERATION PERMIT / EXISTING SYSTEM INSPECTION

PERMIT# 080444 PIN# 4638 68 6799 DATE 4/23/99

OWNER OR CONTRACTOR Gregory Spry PHONE: Business 662-3845 Home

ADDRESS 160 Malibu Rd. Mooresville, NC. 28117

LOCATION Perth Rd N TL Stanley Creek Rd. TL Kiskade Dr, on (R) corner

SUBDIVISION HARBOR VIEW BLOCK / SECTION 2 LOT 11 LOT AREA .58 AC SITE CLASS. RS DESIGN FLOW 360 L.T.A.R. .3

Septic Tank: 1000 Gallons; STB 794 Date 5/18/99
Pump Tank: Gallons; PT Date
Pump Make: Model Serial No.
Nitrification Field: No Fields 1 Square Feet 900 * Linear Feet 300 *
No Lines 4 @ 75' ea' Trench Width 36" Max Trench Bottom Depth 36" Gravel Depth SAND

[X] New System [ ] Repair System Type: I, II, (III) IV, V, VI
System Description: Gravity - Type III
Repair System Description: None
Maintenance Agreement Required: [ ] Yes [X] No

[ ] House/Mod. Home No. Bedrooms 3
[ ] Mobile Home No. Bathrooms 1.5
[ ] Business No. Employees
[ ] Other

[ ] Slab [X] Crawl Space [ ] Basement w/plumbing [ ] Basement wo/plumbing


Water Supply: [ ] Individual [ ] Public [X] Community

Comments/Conditions:


50' R/W KISKA DEE DR.

Comments/Conditions:

INITIAL SITE SKETCH

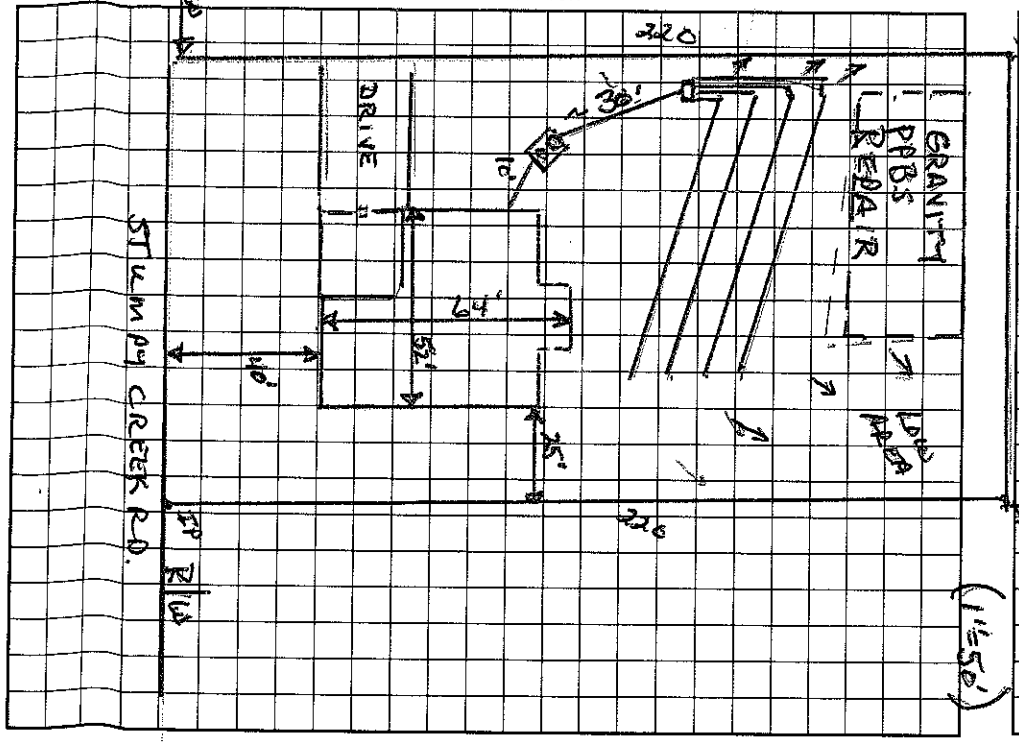

AS BUILT SKETCH

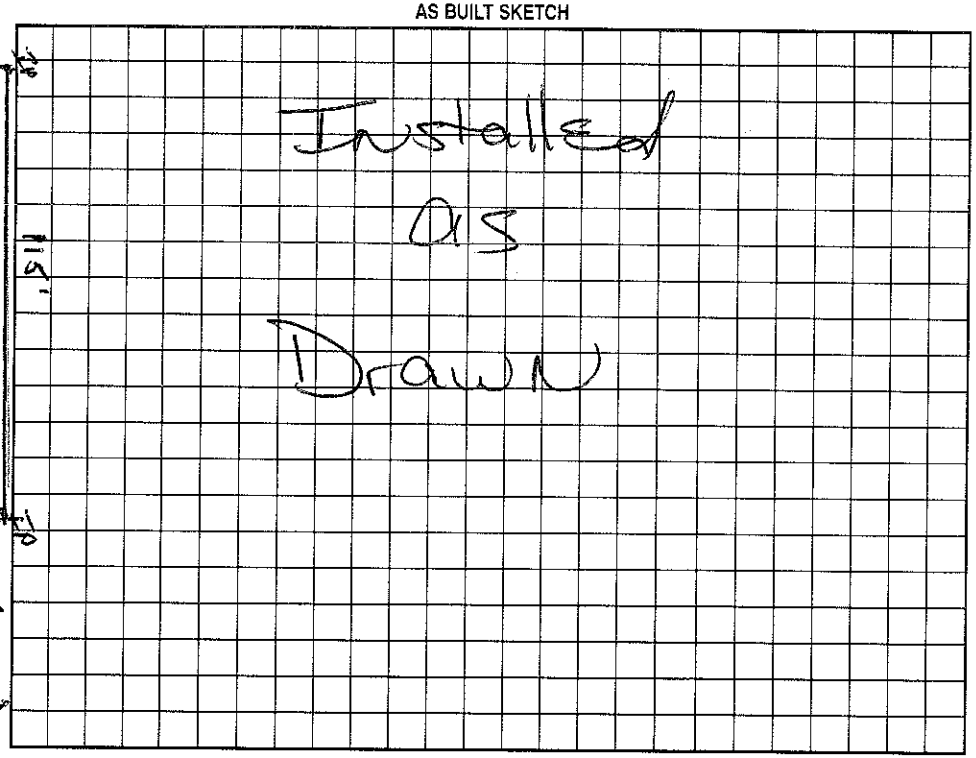

Permit can be suspended or revoked if any false information is supplied toward securing the permit/any unauthorized changes are made to the site/any unauthorized changes are made in the installation of the system. Improvement Permit with plat valid without expiration. Improvement Permit with site plan valid for sixty months. Authorization to Construct is valid for a period equal to that of Improvement Permit – not to exceed sixty months.

Signed: * Greg Spry date 5/4/99

Improvement Permit by: Wesley Sparks RS. date 4/23/99

Authorization to Construct by: Wesley Sparks RS. date 4/23/99

Installed by: James Hudler

Operation Permit by: Maria H. Watson date 9/1/99

Existing System Inspection by: date

HEALTH DEPT. COPY: WHITE OWNER COPY (FINAL): YELLOW OWNER COPY (INITIAL): PINK