IREDELL COUNTY HEALTH DEPARTMENT

STATESVILLE 704-878-5305 MOORESVILLE 704-664-5281

IMPROVEMENT PERMIT / AUTHORIZATION TO CONSTRUCT / OPERATION PERMIT / EXISTING SYSTEM INSPECTION

PERMIT# 066595 PIN# ~~4638 77 9716~~ 4638-68-8388 DATE March 11, '99

OWNER OR CONTRACTOR Stumpy Creek LLC / Carroll Fisher Homes PHONE: Business _____ Home _____

ADDRESS 614 N. Main Salisbury

LOCATION Peach Rd N. TL Stumpy Creek TL Kiskadee on left

SUBDIVISION Harborview BLOCK / SECTION 9 LOT 25 LOT AREA .94Ac SITE CLASS. PS DESIGN FLOW 360gpd L.T.A.R. 0.3

Septic Tank: 1000 Gallons; STB S 25 Date ~~6-1-98~~ 3-1-99

Pump Tank: _____ Gallons; PT _____ Date _____

Pump Make: _____ Model _____ Serial No. _____

Nitrification Field: No Fields 1 Square Feet 900 Linear Feet 300

No Lines 3 Trench Width 36" Max Trench Bottom Depth 36" Gravel Depth NA

☑ New System ☐ Repair System Type: I, II, III, IV, V, VI

System Description: gravity INNOVATIVE

Repair System Description: Gen. PANEL Block

Maintenance Agreement Required: ☐ Yes ☑ No

☑ House/Mod. Home No. Bedrooms 3

☐ Mobile Home No. Bathrooms 2

☐ Business No. Employees _____

☐ Other _____


☐ Slab ☑ Crawl Space ☐ Basement w/plumbing ☐ Basement wo/plumbing

Water Supply: ☐ Individual ☐ Public ☑ Community


Comments:/Conditions:

Comments:/Conditions:

INITIAL SITE SKETCH 1"=60'

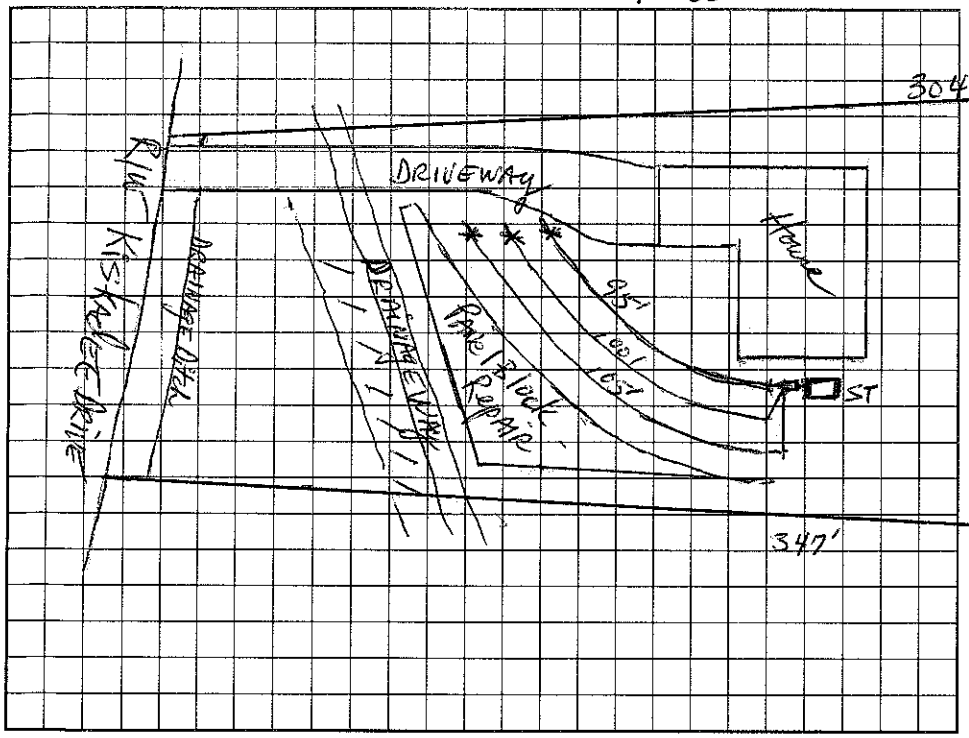

AS BUILT SKETCH

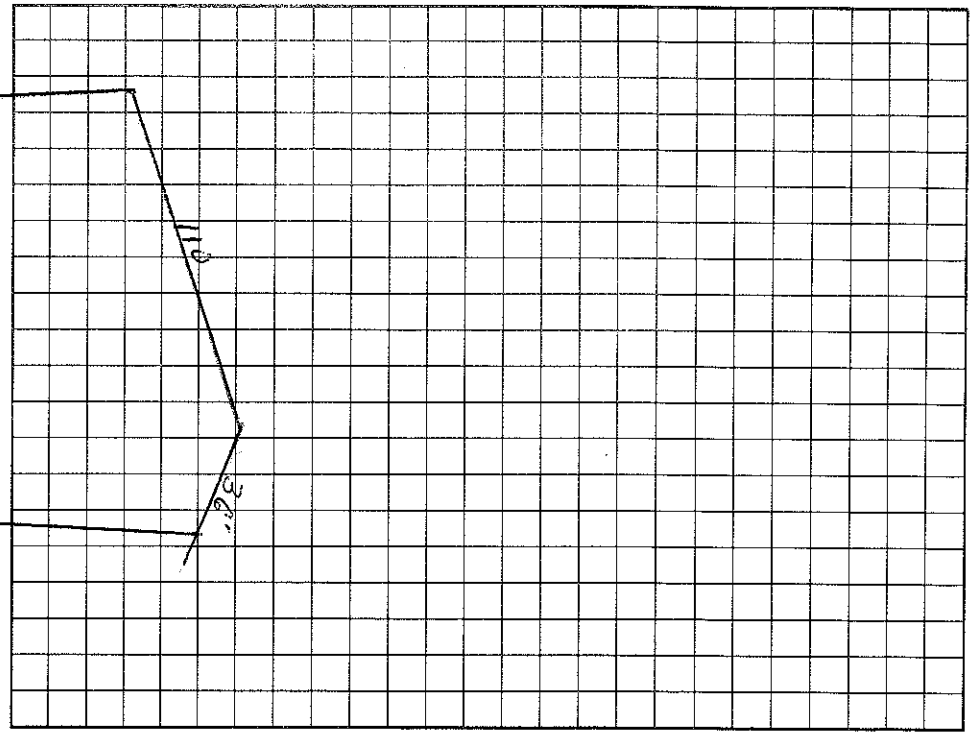

Permit can be suspended or revoked if any false information is supplied toward securing the permit/any unauthorized changes are made to the site/any unauthorized changes are made in the installation of the system. Improvement Permit with plat valid without expiration. Improvement Permit with site plan valid for sixty months. Authorization to Construct is valid for a period equal to that of Improvement Permit – not to exceed sixty months.

Signed: _____ date 3/11/99

Improvement Permit by: _____, RS date 3-11-99

Authorization to Construct by: _____, RS date 3-11-99

Installed by: _____

Operation Permit by: Jeff Morgan date 3/12/99

Existing System Inspection by: _____ date _____

HEALTH DEPT. COPY: WHITE OWNER COPY (FINAL): YELLOW OWNER COPY (INITIAL): PINK