12:00

# IREDELL County HEALTH DEPARTMENT Const. Auth. STATESVILLE 704-878-5305 MOORESVILLE 704-664-5281

## IMPROVEMENT PERMIT / ~~CERTIFICATE OF COMPLETION~~ / OPERATION PERMIT / EXISTING SYSTEM INSPECTI

PROPERTY DESCRIPTION NO. 23214 DATE April 3, '96 TAX MAP NO. part of 25A80 Watershed ☐ Yes

OWNER OR CONTRACTOR Stampy Creek LLC (ELWYN TATUM CONST.) PHONE: Business 633-6124 ~~Home~~ 4638-68-8844

ADDRESS 614 N. Main Salisbury NC 28144

LOCATION 150' W. TR Perth Rd. / TL Stampy Creek Rd. on left 360 GPD.

SUBDIVISION Harbor Green BLOCK / SECTION II LOT 10 LOT AREA .581 Ac SITE CLASS V5 pre 1986 DESIGN FLOW ~~480 gpd~~ 360 gpd L.T.A.R. .3

Septic Tank: 1000 Gallons; STB 325 Date 4/1/97

Pump Tank: _____ Gallons; PT _____ Date _____

Pump Make: _____ Model _____ Serial No. _____

Nitrification Field: No Fields 1 Square Feet 1200 Linear Feet ~~360~~ 300 ALL

No Lines 4@100' Trench Width 36" Max Trench Bottom Depth ± 24" Gravel Depth NA

☒ New System ☐ Repair System Type: I. II. III IV. V. VI

System Description: gravity chambered

Repair System Description: grant/pumped chambered

Maintenance Agreement Required: ☐ Yes ☒ No

☒ House/Mod. Home No. Bedrooms 4

☐ Mobile Home No. Bathrooms 2½

☐ Business No. Employees _____

☐ Other _____

☒ Slab ☐ Crawl Space ☐ Basement w/plumbing ☐ Basement wo/plumbing


Water Supply: ☐ Individual ☐ Communi ☐ Public

Comments:


Comments: 5/13/97 Changed to 360 gpm System - Acres

1" = 60'

### INITIAL SITE SKETCH

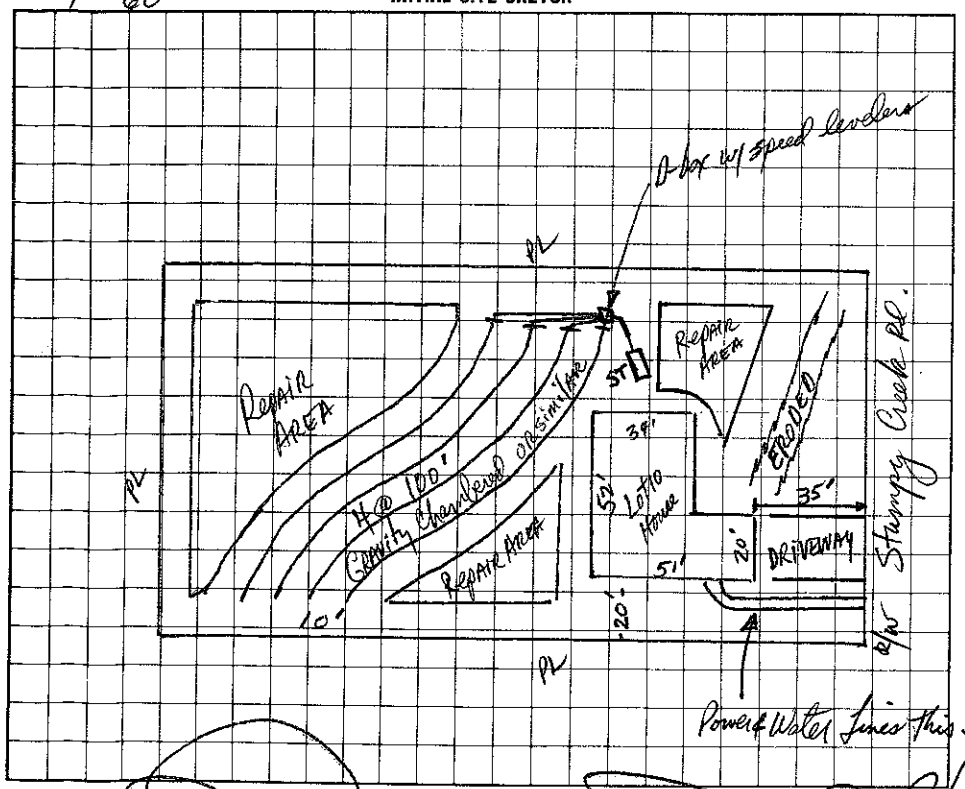


### AS BUILT SKETCH

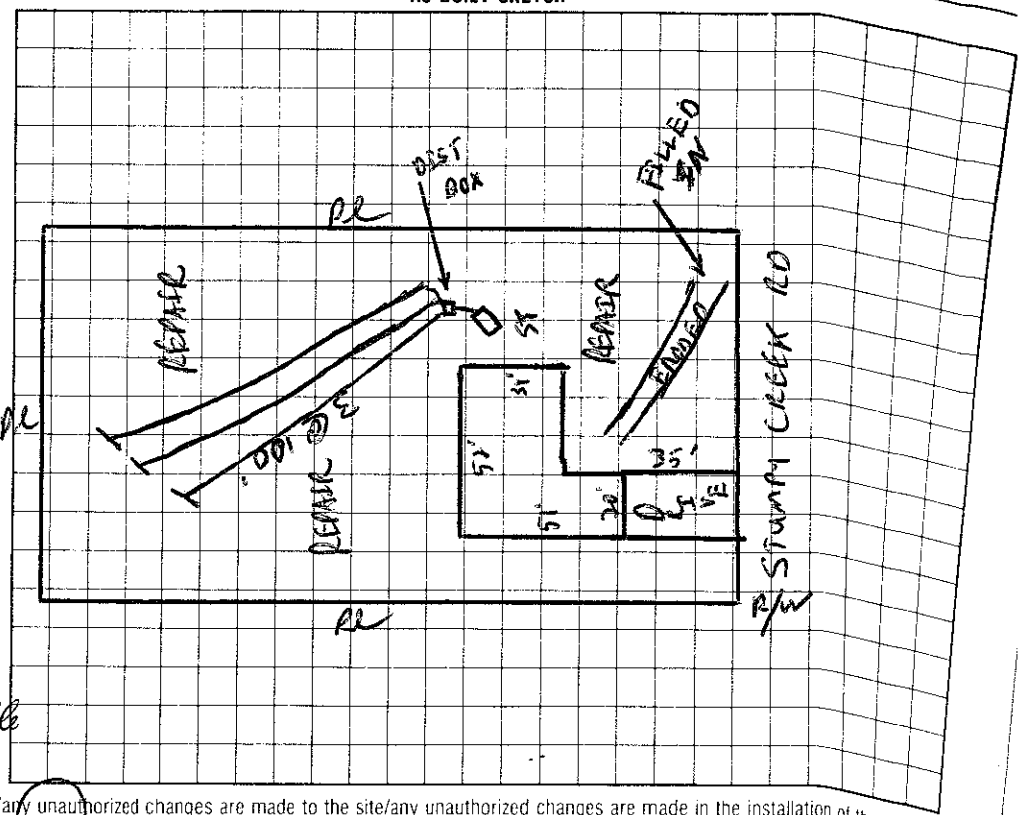


I understand that this permit can be suspended or revoked if any false information is supplied toward securing the permit/any unauthorized changes are made to the site/any unauthorized changes are made in the installation of the system

Signed: _____ Installed by D. BOSTIAN

Improvement Permit by: _____, RS date 4-3-96 Certificate of Completion by: _____ date _____

~~Existing System Inspection by:~~ Construction Authorization Wesley Sparks RS. date 10/24/96 Operation Permit by: _____ date 5/14/97

HEALTH DEPT. COPY: WHITE INSPECTION COPY (FINAL): GREEN OWNER COPY (FINAL): YELLOW INSPECTION COPY (INITIAL): PINK OWNER COPY (INITIAL): GOLD