PAGE 01/01
MOORESVILLE ENV
7046623239
05/10/2012 11:37

IREDELL COUNTY HEALTH DEPARTMENT

Authorization to Construct

STATESVILLE 704-878-5305 MOORESVILLE 704-664-5281

IMPROVEMENT PERMIT / CERTIFICATE OF COMPLETION / OPERATION PERMIT / EXISTING SYSTEM INSPECTION

PROPERTY DESCRIPTION NO. 23213 DATE Sep. 30, 1996 TAX MAP NO. pt. of 25A 80

OWNER OR CONTRACTOR Buddy DeHart PHONE: Business 664-3825 Home 4638-68-9858 Waterline: ☒ Yes ☐ No

ADDRESS 118 Queens Rd. Mooresville NC.

LOCATION 150 W Plaza Rd. to Stumpy Creek Rd. on left.

SUBDIVISION HARBORVIEW BLOCK / SECTION II LOT 9 LOT AREA .58Ac SITE CLASS. 25 DESIGN FLOW 360 L.T.A.R. .3

Septic Tank: 1000 Gallons: STB 525 Date 11/4/96 ☒ New System ☐ Repair System Type: I, II, ☒ IV, V, VI

Pump Tank: ____ Gallons: PT ____ Date ____ System Description: CH PLASTIC

Pump Make: ____ Model ____ Serial No. ____ Repair System Description: SAME

Nitrification Field: No Rolls 1 Square Feet 1200 Linear Feet 360 Maintenance Agreement Required: ☐ Yes ☐ No

No Lines 4 Trench Width 36" Max Trench Bottom Depth 36" Gravel Depth STND ☐ Slab ☒ Crawl Space ☐ Basement w/plumbing ☐ Basement w/o plumbing


☒ House/Mod. Home ☐ Mobile Home ☐ Business ☐ Other No. Bedrooms 3 No. Bathrooms 3 No. Employees ____

Water Supply: ☐ Individual ☒ Community ☐ Public


Comments:

Comments:

INITIAL SITE SKETCH

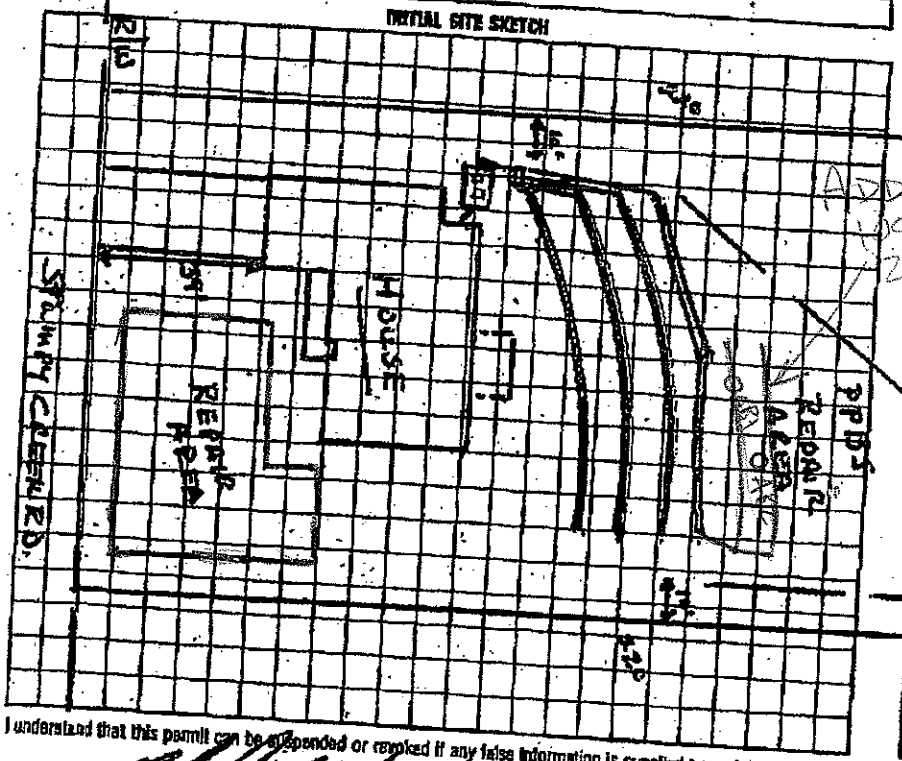

AS BUILT SKETCH

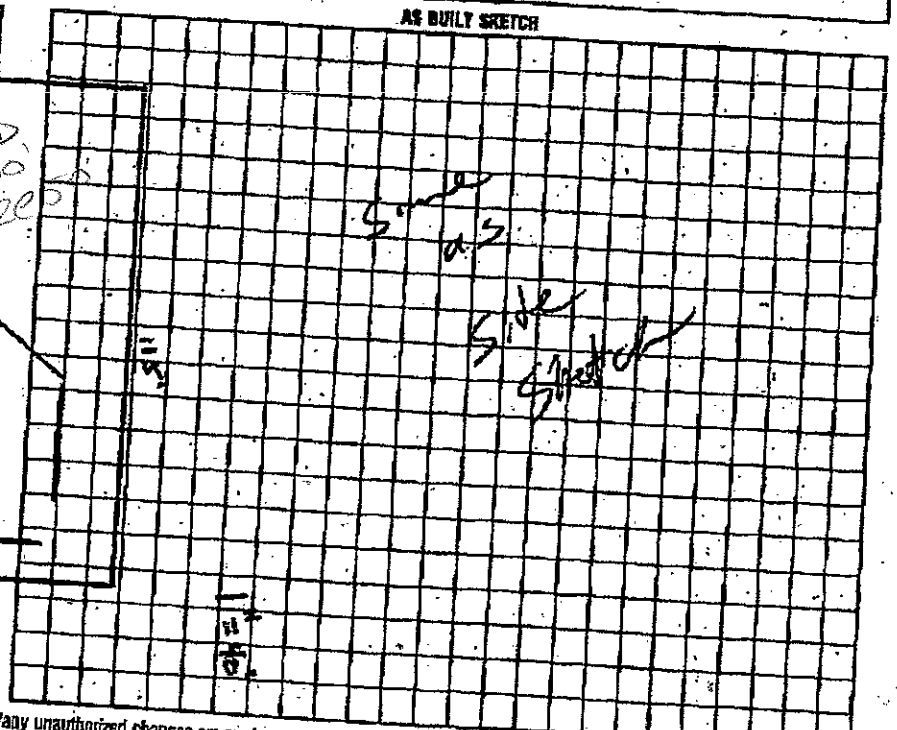

I understand that this permit can be suspended or revoked if any false information is supplied toward securing the permit/any unauthorized changes are made to the site/any unauthorized changes are made in the installation of the system.

Signed: E.T. Helms (E. Tate) for

Improvement Permit by: DRH date 4/2/96

Original System Inspection by: Wesley Sparks RS. date 9/30/96

Installed by: DeHart Construction

Certificate of Completion by: ____

Operation Permit by: C. Fellenstein EHSE date 11/4/97

HEALTH DEPT. COPY: WHITE INSPECTION COPY (FINAL): GREEN OWNER COPY (FINAL): YELLOW